IREDELL COUNTY HEALTH DEPARTMENT

STATESVILLE 704-878-5305 MOORESVILLE 704-664-5281

IMPROVEMENT PERMIT / AUTHORIZATION TO CONSTRUCT / OPERATION PERMIT / EXISTING SYSTEM INSPECTION

PERMIT# REPAIR PIN# DATE 2-17-99

OWNER OR CONTRACTOR RICHARD RACKLEY PHONE: Business Home 871-2094

ADDRESS 2510 FIRST STREET STATESVILLE NC 28625

LOCATION WEST FRONT STREET, TL 9 STREET TL 9 FIRST STREET 2ND HOUSE ON (L)

SUBDIVISION BLOCK / SECTION LOT LOT AREA LIMITED SITE CLASS PS DESIGN FLOW 360 L.T.A.R. EXISTING

Septic Tank: ~~EXISTING~~ Gallons: STB Date

Pump Tank: Gallons: PT Date

Pump Make: Model Serial No

Nitrification Field: No Fields 1 Square Feet 300 Linear Feet 100

No Lines ONE Trench Width 36" Max Trench Bottom Depth 36"+

☐ New System ☑ Repair System Type: I (II) III, IV, V, VI

System Description:

Repair System Description: CONV. GRAVITY

Maintenance Agreement Required: ☐ Yes ☑ No

Gravel Depth (24") ☐ Slab ☐ Crawl Space Basement w/plumbing ☐ Basement wo/plumbing

☑ House/Mod. Home No. Bedrooms 3

☐ Mobile Home No. Bathrooms 2

☐ Business No. Employees


☐ Other

Water Supply: ☐ Individual ☑ Public ☐ Community


Comments/Conditions: ① THIS PERMIT SERVES AS NOTICE OF VIOLATION ② REPLACE SANITARY TEE IF NECESSARY

Comments/Conditions:

INITIAL SITE SKETCH

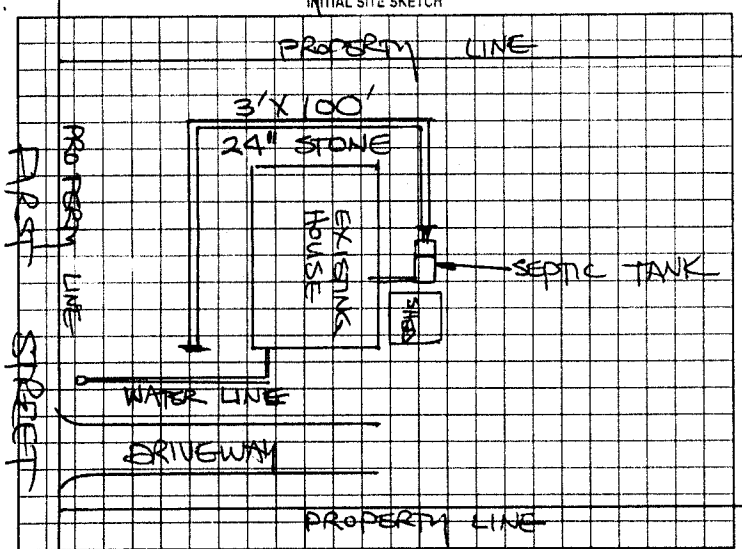

AS BUILT SKETCH

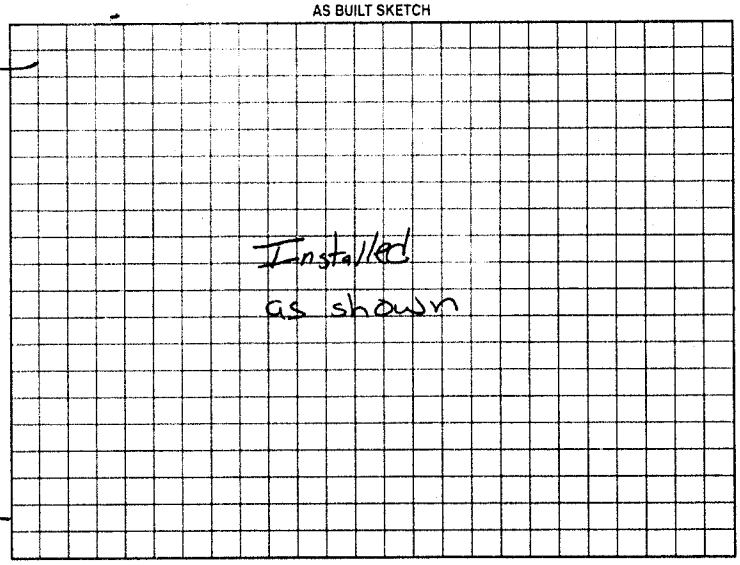

Permit can be suspended or revoked if any false information is supplied toward securing the permit/any unauthorized changes are made to the site/any unauthorized changes are made in the installation of the system. Improvement Permit with plat valid without expiration. Improvement Permit with site plan valid for sixty months. Authorization to Construct is valid for a period equal to that of Improvement Permit – not to exceed sixty months.

Signed: + Richard Rackley date 2/17/99 Installed by: Steve Jolley

Improvement Permit by: STEVE HEDRICK date 2-17-99 Operation Permit by: Mat Coty RS date 4-9-99

Authorization to Construct by: STEVE HEDRICK date 2-17-99 Existing System Inspection by: date

HEALTH DEPT COPY WHITE OWNER COPY (FINAL) YELLOW OWNER COPY (INITIAL) PINK