IREDELL COUNTY HEALTH DEPARTMENT

STATESVILLE 704-878-5305 MOORESVILLE 704-664-5281

IMPROVEMENT PERMIT / AUTHORIZATION TO CONSTRUCT / OPERATION PERMIT / EXISTING SYSTEM INSPECTION

PERMIT# Repair PIN# DATE 4-16-99

OWNER OR CONTRACTOR Julia McClelland PHONE: Business Home 8381643

ADDRESS 2204 Kennedy Dr. Statesville

LOCATION 70W TL Park Ave. TL Williams follow thru Rita Ave TL kennedy on (R)

SUBDIVISION BLOCK / SECTION LOT LOT AREA SITE CLASS DESIGN FLOW 360 L.T.A.R. Existing

Septic Tank: 1000 Ex Gallons; STB Date

Pump Tank: Gallons; PT Date

Pump Make: Model Serial No.

Nitrification Field: No Fields 1 Square Feet Linear Feet 105+

No Lines 1 Trench Width 36in Max Trench Bottom Depth 36in Gravel Depth 24in

☐ New System ☒ Repair System Type: I, (II), III, IV, V, VI

System Description:

Repair System Description: Gravity Conventional

Maintenance Agreement Required: ☐ Yes ☒ No

☒ House/Mod. Home No. Bedrooms 3

☐ Mobile Home No. Bathrooms 1

☐ Business No. Employees

☐ Other

☐ Slab ☒ Crawl Space ☐ Basement w/plumbing ☐ Basement wo/plumbing

Water Supply: ☐ Individual ☐ Public ☒ Community well


Comments/Conditions: Install line with 24 stone

This Permit serves as Notice of Violation


Comments/Conditions:

* Note Dave to old Line location only able to get 6x55 ft Bed 24in stone

INITIAL SITE SKETCH

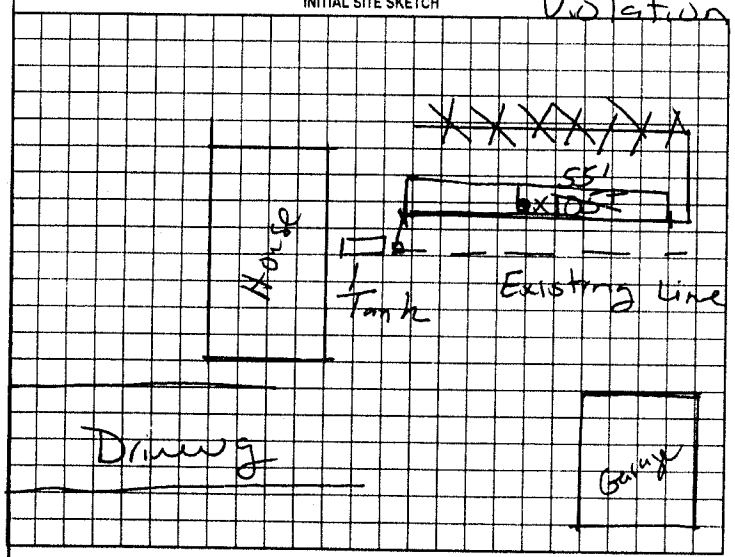

AS BUILT SKETCH

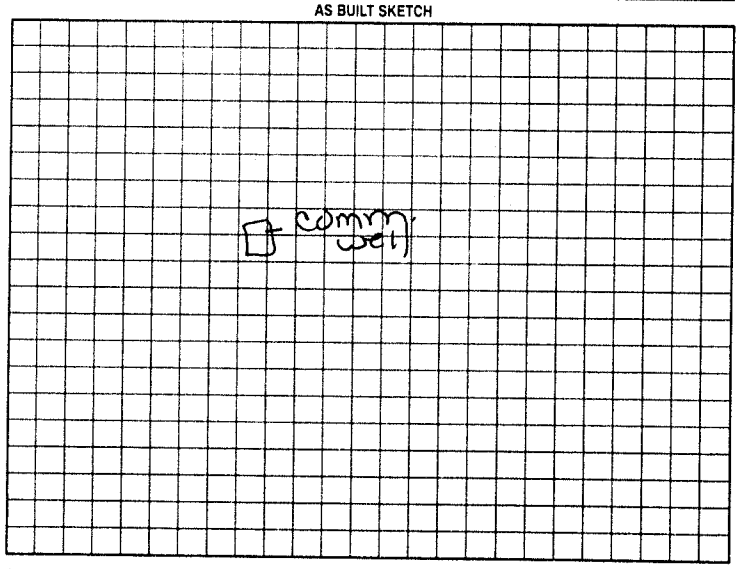

Permit can be suspended or revoked if any false information is supplied toward securing the permit/any unauthorized changes are made to the site/any unauthorized changes are made in the installation of the system. Improvement Permit with plat valid without expiration. Improvement Permit with site plan valid for sixty months. Authorization to Construct is valid for a period equal to that of Improvement Permit - not to exceed sixty months.

Signed: Julia McClelland date 4-16-99 Installed by: Berry Sigmon

Improvement Permit by: Mark Ost RS date 4-16-99 Operation Permit by: Mark Ost RS date 8-5-99

Authorization to Construct by: Mark Ost RS date 4-16-99 Existing System Inspection by: date

HEALTH DEPT COPY WHITE OWNER COPY (FINAL) YELLOW OWNER COPY (INITIAL) PINK