IREDELL COUNTY HEALTH DEPARTMENT

STATESVILLE 704-878-5305 MOORESVILLE 704-664-5281

IMPROVEMENT PERMIT / AUTHORIZATION TO CONSTRUCT / OPERATION PERMIT / EXISTING SYSTEM INSPECTION

PERMIT# REPAIR PIN#

OWNER OR CONTRACTOR SHEILA SUMMERS PHONE: Business 878-6645 Home 924-8964 DATE 9-19-98

ADDRESS 1313 WILLIAMS ROAD STATESVILLE, NC 28677

LOCATION US 70 WEST, TL PARK DRIVE, TR WILLIAMS ROAD, AT END ON LEFT

SUBDIVISION _____ BLOCK / SECTION _____ LOT _____ LOT AREA LIMITED SITE CLASS: PS DESIGN FLOW 600 L.T.A.R. EXISTING

Septic Tank: EXISTING Gallons; STB _____ Date 9-29-98

Pump Tank: _____ Gallons; PT _____ Date DELLINGER

Pump Make: _____ Model _____ Serial No. _____

Nitrification Field: No Fields ____ Square Feet _____ Linear Feet EXISTING

No Lines _____ Trench Width _____ Max Trench Bottom Depth _____ Gravel Depth _____

☐ New System ☑ Repair System Type: I, II, III, IV, V, VI

System Description: CONVENTIONAL GRAVITY

Repair System Description: _____

Maintenance Agreement Required: ☐ Yes ☑ No

☑ House/Mod. Home 2 No. Bedrooms 5

☐ Mobile Home No. Bathrooms ____

☐ Business No. Employees ____

☐ Other TWO HOUSES


☐ Slab ☑ Crawl Space ☐ Basement w/plumbing ☐ Basement wo/plumbing

Water Supply: ☐ Individual ☑ Public ☐ Community


Comments:/Conditions: REPLACE CRACKED HAND-MADE SEPTIC TANK LID WITH PRECAST REINFORCED CONCRETE TANK LID WITH TWO ACCESS OPENINGS PER 130A .1954 (a)

Comments:/Conditions: ① SEPTIC TANK HAS NO BAFFLE-WALL & NO SANITARY TEE ② NEW LID WAS POURED 9-29-98 W/ ADDITIONAL REINFORCEMENT FOR IMMEDIATE INSPECTION.

INITIAL SITE SKETCH

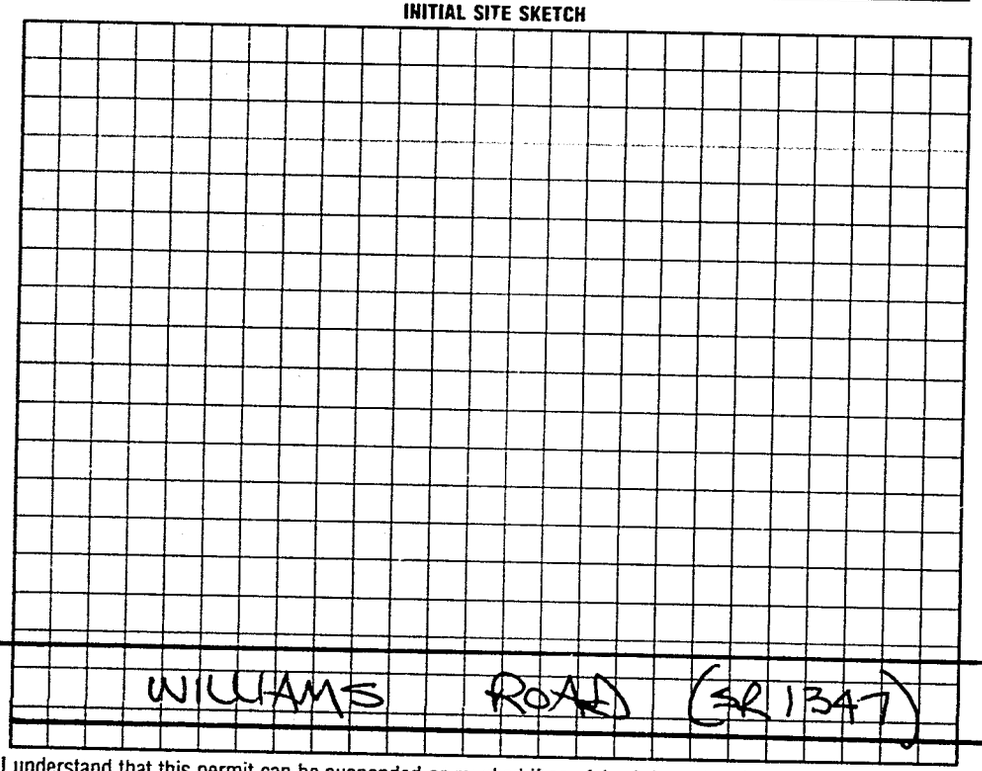

AS BUILT SKETCH

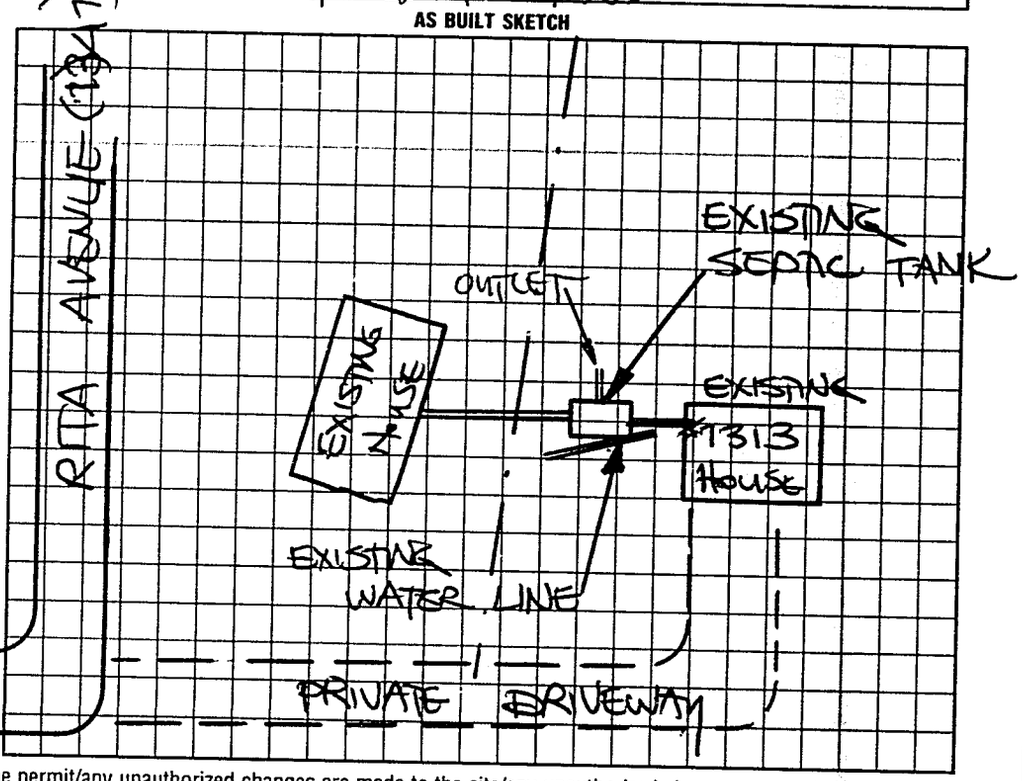

I understand that this permit can be suspended or revoked if any false information is supplied toward securing the permit/any unauthorized changes are made to the site/any unauthorized changes are made in the installation of the system. Improvement Permit with plat valid without expiration. Improvement Permit with site plan valid for sixty months. Authorization to Construct is valid for a period equal to that of Improvement Permit – not to exceed sixty months.

Signed: + Sheila Summers date 9-19-98

Improvement Permit by: STEVE HEDRICK date 9-19-98

Authorization to Construct by: STEVE HEDRICK date 9-19-98

Installed by: DELLINGER SEPTIC TANK COMPANY

Operation Permit by: STEVE HEDRICK date 10-2-98

Existing System Inspection by: _____ date _____

HEALTH DEPT COPY WHITE INSPECTION COPY (FINAL) GREEN OWNER COPY (FINAL) YELLOW INSPECTION COPY (INITIAL) PINK OWNER COPY (INITIAL) GOLD