IREDELL COUNTY HEALTH DEPARTMENT

STATESVILLE 704-878-5305 MOORESVILLE 704-664-5281

IMPROVEMENT PERMIT / AUTHORIZATION TO CONSTRUCT / OPERATION PERMIT / EXISTING SYSTEM INSPECTION

PERMIT# REPAIR PIN# 4724-83-2145 DATE 9-11-03

OWNER OR CONTRACTOR ALVIN SHERRILL PHONE: Business Home 704-872-4037

ADDRESS 2253 BRISTOL ROAD STATESVILLE, NC 28677-4805

LOCATION US 70 WEST, TL BRISTOL ROAD, 0.1 MILE ON RIGHT AT BOX # 2253

SUBDIVISION BLOCK / SECTION LOT LOT AREA LIMITED SITE CLASS. PS DESIGN FLOW 240 L.T.A.R. 0.40 GPD/FT²

Septic Tank: EXISTING Gallons; STB Date

Pump Tank: Gallons; PT Date

Pump Make: Model Serial No.

Nitrification Field: No Fields 1 Square Feet 600 Linear Feet 200

No Lines 2 Trench Width 36" Max Trench Bottom Depth 36" Gravel Depth 12"

☐ New System ☑ Repair System Type: I, II, III, IV, V, VI

System Description:

Repair System Description: CONVENTIONAL GRAVITY

Maintenance Agreement Required: ☐ Yes ☑ No

☑ House/Mod. Home No. Bedrooms 2

☐ Mobile Home No. Bathrooms 1

☐ Business No. Employees

☐ Other


☐ Slab ☑ Crawl Space ☐ Basement w/plumbing ☐ Basement wo/plumbing

Water Supply: ☑ Individual ☐ Public ☐ Community WELL

Comments:/Conditions: ~~SEPTIC EASEMENT TO BE RECORDED ON DEED PRIOR TO INSTALLATION~~ (2) USE 32 OUNCES COPPER SULFATE ANNUALLY IN SYSTEM TO CONTROL ROOT GROWTH.

Comments:/Conditions: SEE ATTACHED DEED RECOMBINATION

INITIAL SITE SKETCH

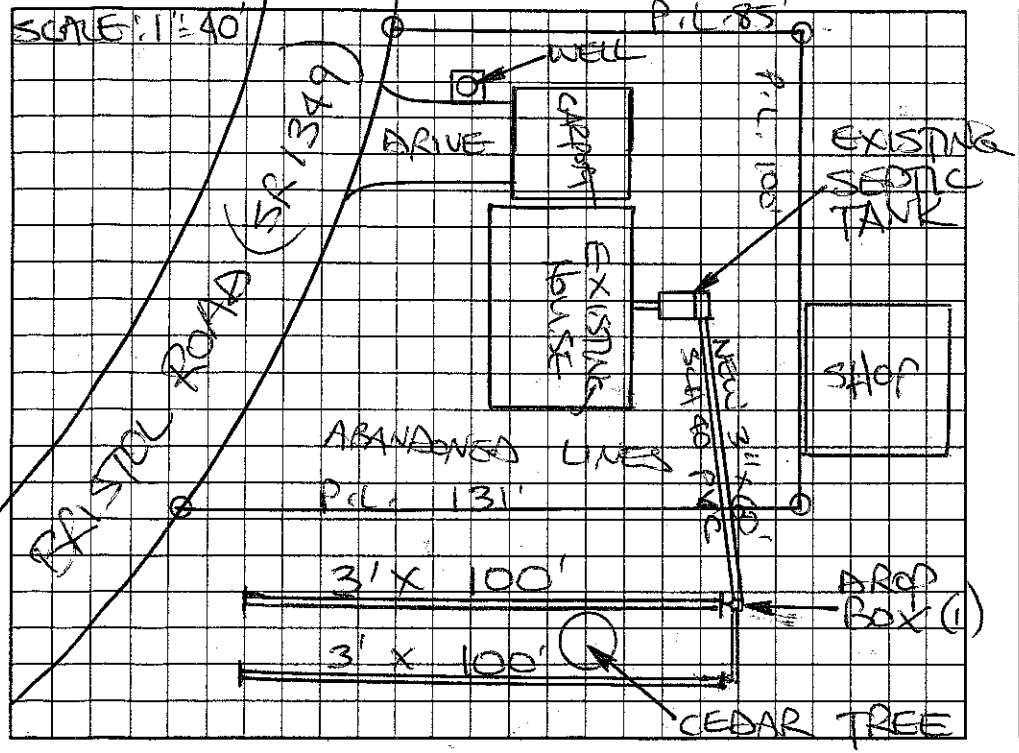

AS BUILT SKETCH

SYSTEM REPAIRED ACCORDING TO INITIAL SITE SKETCH

Permit can be suspended or revoked if any false information is supplied toward securing the permit/any unauthorized changes are made to the site/any unauthorized changes are made in the installation of the system. Improvement Permit with plat valid without expiration. Improvement Permit with site plan valid for sixty months. Authorization to Construct is valid for a period equal to that of Improvement Permit – not to exceed sixty months.

Signed: Alvin Sherrill date 9/11/03 Installed by: IREDELL BACKHOE

Improvement Permit by: STEVE HEDRICK date 9-11-03 Operation Permit by: STEVE HEDRICK date 9-25-03

Authorization to Construct by: STEVE HEDRICK date 9-11-03 Existing System Inspection by: date

HEALTH DEPT. COPY: WHITE OWNER COPY (FINAL): YELLOW OWNER COPY (INITIAL): PINK