IREDELL COUNTY HEALTH DEPARTMENT

Statesville Phone TR 3-7271 Mooresville Phone NO 3-1271

PERMIT TO INSTALL SEPTIC TANK

Permit Date June 10, 195 9

Permit NO. _____

Owner Walter Bustle Address Bristol Rd

Installed By C Hoke Address R7.


Location of Property out Hickory Rd to lines go. left on Bristol Rd. 1st on Right

Tank		Capacity		Length of Lines		Fixtures	
Block	( )	800	( )	150'	( )	No. of Baths	( )
Precast	( )	900	( )	175'	( )	Dishwasher	( )
		1000	( )	200'	( )	Garbage Grdr.	( )
		1100	( )	225'	( )	Auto-Washer	( )
		1200	( )	250'	( )	Other	
		Other		Other			

NOTIFY HEALTH DEPARTMENT AT LEAST EIGHT HOURS BEFORE TANK IS TO BE INSPECTED.

Final Inspection June 10 195 9 Approved ( ) Disapproved ( )

Remarks Self apply Pa Tel.

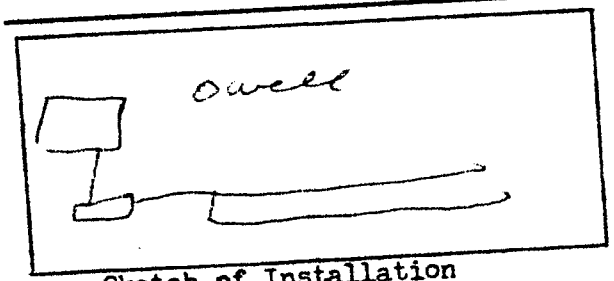

Sketch of Installation

Raford C. Hoke

Sanitarian