IREDELL COUNTY HEALTH DEPARTMENT STATESVILLE 704-878-5305 MOORESVILLE 704-664-5281

IMPROVEMENT PERMIT / AUTHORIZATION TO CONSTRUCT / OPERATION PERMIT / EXISTING SYSTEM INSPECTION

PERMIT # Repair PIN # 4724833571 DATE 12-9-08

OWNER or APPLICANT Mickey Gaither PHONE: Business Home:

OWNER or APPLICANT ADDRESS 2250 Bristol Road

LOCATION / DIRECTIONS 70 W to Bristol 20 1st house on Left

SUBDIVISION BLOCK / SECTION LOT # LOT AREA DESIGN FLOW 240 L.T.A.R. 12

Septic Tank 1000 Gallons: STB 844.08 Date 7/10/08 ☑ New System ☑ Repair ☐ Expansion System Type I II III IV V VI

Pump Tank Gallons: P T Date System Description: 25% Grave

Pump Make Model Serial # Repair System Description: 35% Gravel

Nitrification Field No Fields No Lines Linear Feet 200 Maintenance Agreement Required ☐ YES ☑ NO

Trench Width 36" Max. Trench Bottom Depth 36" Gravel Depth MA ☑ GRAVITY ☐ PRESSURE

☑ Residence No. Bedrooms 2 ☐ Business No. Persons ☐ Other No. Employees ☐ Slab ☐ Crawl Space ☐ Basement w/plumbing ☐ Basement w/o plumbing

Water Supply: ☐ Private ☑ Public ☐ Community


Comments / Conditions

Installed on Contour
Maintain all setbacks

Comments / Conditions

Red Tag - Utl

INITIAL SITE SKETCH

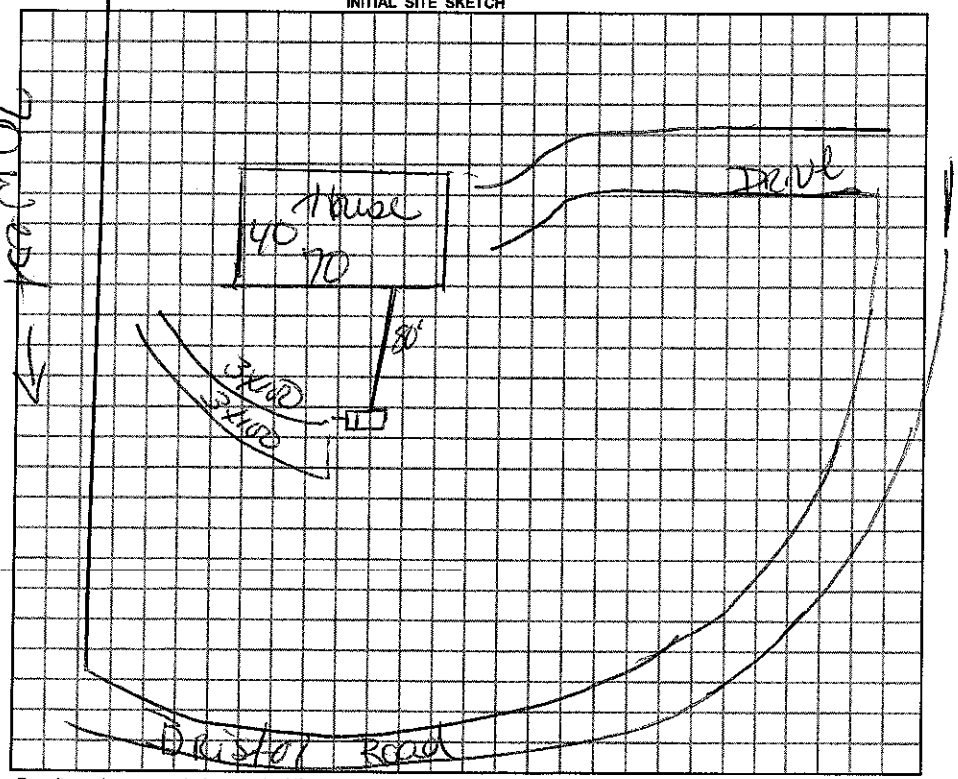

AS-BUILT SKETCH

Septic Mound

Permit can be suspended or revoked if any false information is supplied toward securing the permit / any unauthorized changes are made to the site / any unauthorized changes are made in the installation of the system.

☐ IMPROVEMENT PERMIT w / plat valid without expiration. ☐ IMPROVEMENT PERMIT w / site plan valid for 60 mos. ☑ AUTHORIZATION TO CONSTRUCT valid for period equal to IMPROVEMENT PERMIT-not to exceed 60 mo.

Owner / Applicant Signature: Dennis Gaither Date 12-9-08

Improvement Permit by: Date 12-9-08

Authorization to Construct by: Date 12-9-08

YOU SHOULD CONTACT A LOCATOR SERVICE PRIOR TO ANY EXCAVATION.

Installed by: A-1 Backhoe

Operation Permit by: Date: 12-15-08

Existing System Inspected by: Date:

WHITE COPY Environmental Health YELLOW COPY (Final) Owner / Applicant PINK COPY (Initial) Owner / Applicant