IREDELL COUNTY HEALTH DEPARTMENT

STATESVILLE 704-878-5305 (01) MOORESVILLE 704-664-5281

IMPROVEMENT PERMIT / AUTHORIZATION TO CONSTRUCT / OPERATION PERMIT / EXISTING SYSTEM INSPECTION

PERMIT# 13207 PIN# 4724-90-5635 DATE 10-24-05

OWNER OR CONTRACTOR SHIRLEY A. RUCKER PHONE: Business 704-450-4942 Home 704-871-8160

ADDRESS 2042 LYNDON DRIVE STATESVILLE, NC 28677

LOCATION PARK DRIVE TO TR WILLIAMS, CONTINUE RITA AV TL KENNEDY TR LYNDON DR, BEAR LEFT TO END

SUBDIVISION LINCOLN ESTATES BLOCK / SECTION II LOT 50 LOT AREA 0.68 ACRE SITE CLASS. 1 PS DESIGN FLOW 360 L.T.A.R. 0.30 GPD/FT²

Septic Tank: 1000 Gallons; STB 794 Date 1-12-08

Pump Tank: _____ Gallons; PT _____ Date _____

Pump Make: _____ Model _____ Serial No. _____

Nitrification Field: No Fields 1 Square Feet 40 TO 1200 Linear Feet 300

No Lines SIX Trench Width 36" Max Trench Bottom Depth 36" Gravel Depth N/A

☑ New System ☐ Repair System Type: I (II) III IV V VI

System Description: 25% REDUCTION GRAVITY

Repair System Description: 50% REDUCTION LOW PRESSURE

Maintenance Agreement Required: ☐ Yes ☑ No

☐ House/Mod. Home No. Bedrooms 3

☑ Mobile Home No. Bathrooms ____

☐ Business No. Employees ____

☐ Other _____


☐ Slab ☑ Crawl Space ☐ Basement w/plumbing ☐ Basement wo/plumbing

Water Supply:
☐ Individual
☐ Public
☐ Community

Comments:/Conditions:

INSTALL 25% REDUCTION SYSTEM ON CONTOUR AS FLAGGED ON-SITE.


INITIAL SITE SKETCH

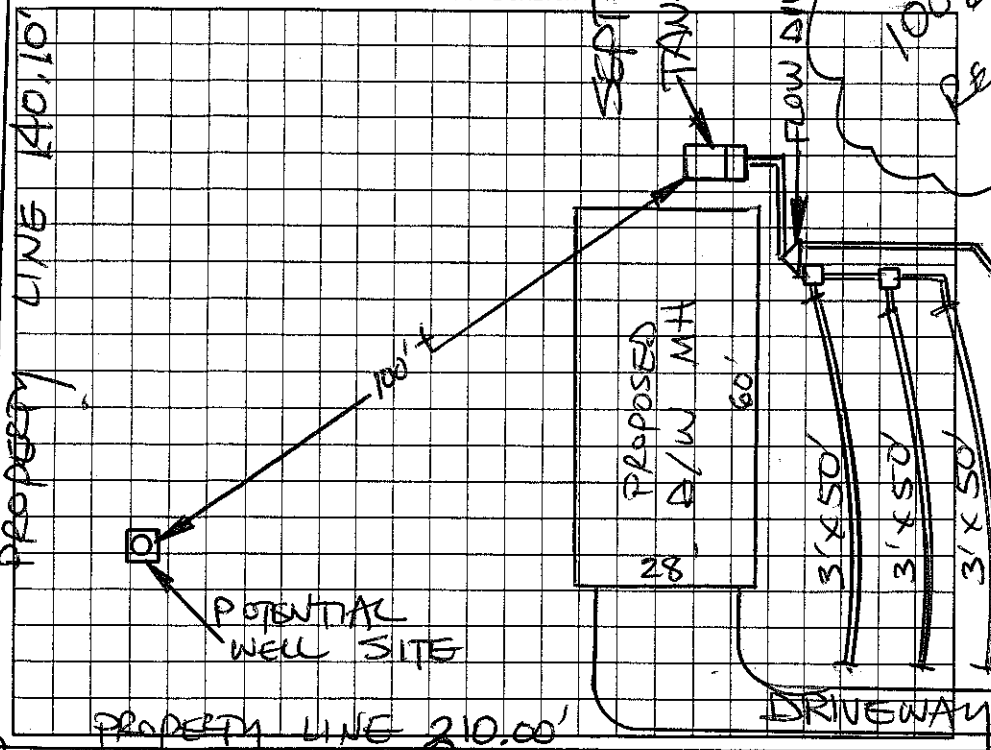

Comments:/Conditions:

SEPTIC TANK WITH MARKER INSTALLED USING RED "POLY-OK" FILTER

AS BUILT SKETCH

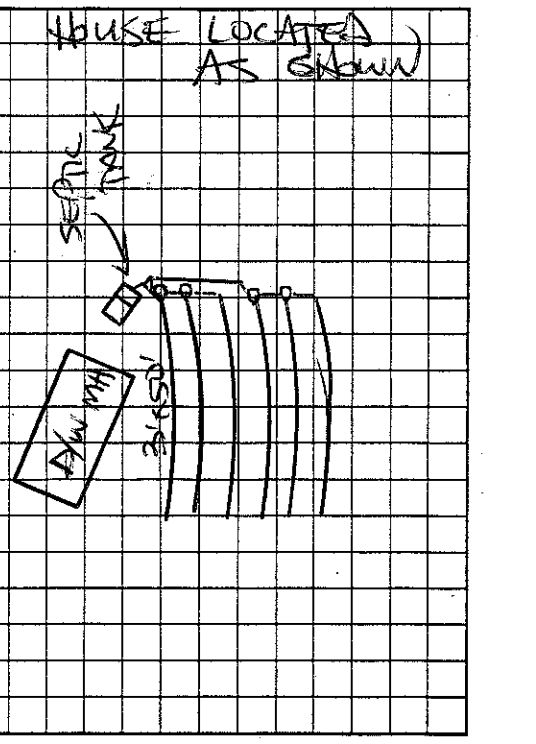

Permit can be suspended or revoked if any false information is supplied toward securing the permit/any unauthorized changes are made to the site/any unauthorized changes are made in the installation of the system. Improvement Permit with plat valid without expiration. Improvement Permit with site plan valid for sixty months. Authorization to Construct is valid for a period equal to that of Improvement Permit – not to exceed sixty months.

Signed: Donald & Shirley Rucker date 1-30-06 Installed by: TUCKER'S HAULING & GRADING

Improvement Permit by: STEVE HEDRICK date 10-24-05 Operation Permit by: STEVE HEDRICK date 4-15-08

Authorization to Construct by: STEVE HEDRICK date 10-24-05 Existing System Inspection by: _____ date _____

HEALTH DEPT. COPY: WHITE OWNER COPY (FINAL): YELLOW OWNER COPY (INITIAL): PINK