IREDELL COUNTY HEALTH DEPARTMENT

STATESVILLE 704-878-5305 MOORESVILLE 704-664-5281

IMPROVEMENT PERMIT / AUTHORIZATION TO CONSTRUCT / OPERATION PERMIT / EXISTING SYSTEM INSPECTION

PERMIT# REPAIR PIN#

OWNER OR CONTRACTOR ROOSEVELT & MILDRED BOOKER PHONE: Business Home 872-8345 DATE 11-12-98

ADDRESS 2030 KENNEDY DRIVE STATESVILLE NC 28677

LOCATION PARK DRIVE, TR WILLIAMS ROAD, CONTINUE RITA AVE, TL KENNEDY, ON RIGHT AT BOX # 2107

SUBDIVISION BLOCK / SECTION LOT LOT AREA LIMITED SITE CLASS. PS1 DESIGN FLOW 360 L.T.A.R. EXISTING

Septic Tank: 1000 Gallons; STB 1012 Date 9-9-98
Pump Tank: Gallons; PT Date
Pump Make: Model Serial No.
Nitrification Field: No Fields Square Feet Linear Feet EXISTING
No Lines Trench Width Max Trench Bottom Depth Gravel Depth

☐ New System ☑ Repair System Type: I, II, III, IV, V, VI
System Description: CONV. GRAVITY
Repair System Description: CONV. GRAVITY
Maintenance Agreement Required: ☐ Yes ☑ No


☑ House/Mod. Home No. Bedrooms 3
☐ Mobile Home No. Bathrooms 1
☐ Business No. Employees
☐ Other
☐ Slab ☐ Crawl Space ☑ Basement w/plumbing ☐ Basement wo/plumbing

Water Supply: ☐ Individual ☑ Public ☐ Community


Comments:/Conditions: ① REPLACE COLLASPED SEPTIC TANK WITH NEW SEPTIC TANK AS SHOWN ② PUMP OUT EXISTING SEPTIC TANK BEFORE FILLING WITH DIRT

Comments:/Conditions: THIS PERMIT SERVES AS NOTICE OF VIOLATION

INITIAL SITE SKETCH

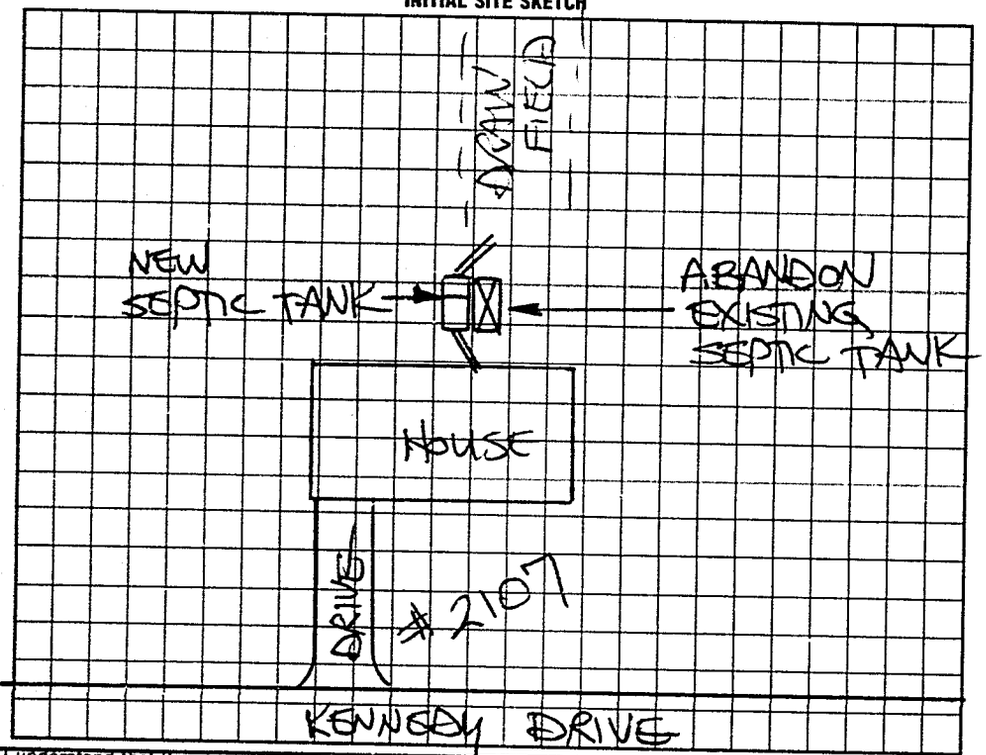

AS BUILT SKETCH

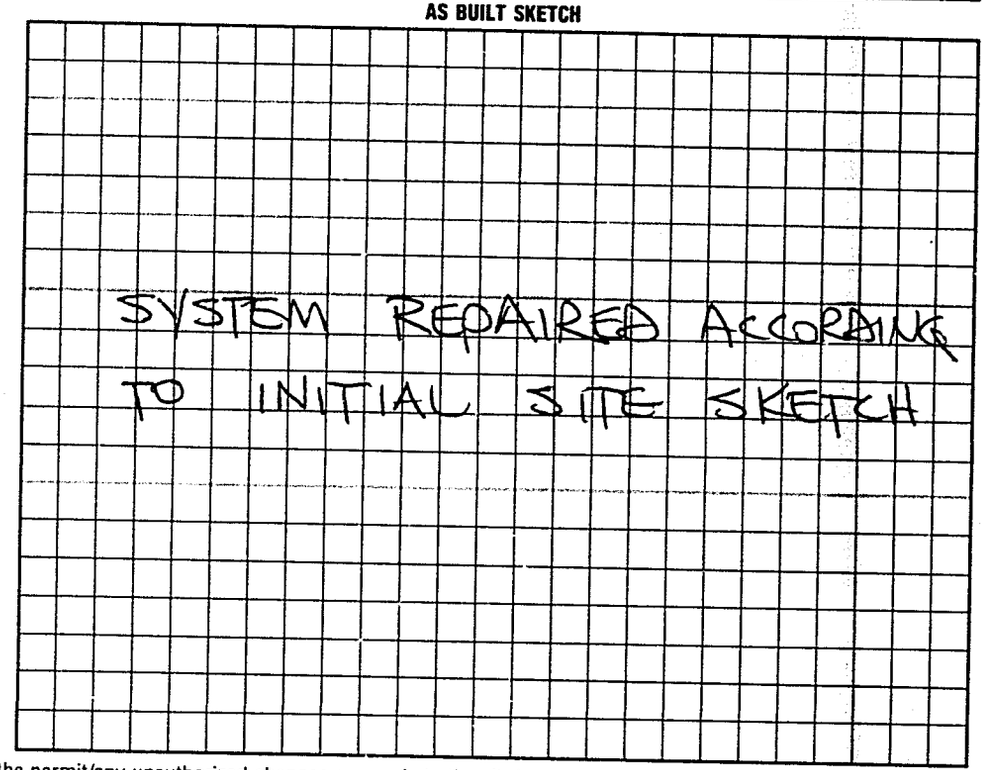

I understand that this permit can be suspended or revoked if any false information is supplied toward securing the permit/any unauthorized changes are made to the site/any unauthorized changes are made in the installation of the system. Improvement Permit with plat valid without expiration. Improvement Permit with site plan valid for sixty months. Authorization to Construct is valid for a period equal to that of Improvement Permit – not to exceed sixty months.

Signed: Mildred Booker date 11-12-98

Improvement Permit by: STEVE HEDRICK date 11-12-98

Authorization to Construct by: STEVE HEDRICK date 11-12-98

Installed by: STEVE JORDAN

Operation Permit by: STEVE HEDRICK date 11-17-98

Existing System Inspection by date

HEALTH DEPT COPY: WHITE INSPECTION COPY (FINAL): GREEN OWNER COPY (FINAL): YELLOW INSPECTION COPY (INITIAL): PINK OWNER COPY (INITIAL): GOLD