IREDELL COUNTY HEALTH DEPARTMENT

Statesville Phone TR 3-7271

Mooresville Phone NO 3-1271

Permit NO. _____

PERMIT TO INSTALL SEPTIC TANK

Permit Date MAY 22 1958

Owner E.B. COHEN

Address STATESVILLE

Installed By C. HOKE

Address _____

Location of Property ONE PARK DRIVE - RT AT 6 MI'S PLACE 1ST HOUSE - LEFT

Tank		Capacity		Length of Lines		Fixtures	
Block	( )	800	(✓)	150'	(✓)	No. of Baths	(/)
Precast	(✓)	900	( )	175'	( )	Dishwasher	( )
		1000	( )	200'	( )	Garbage Grdr.	( )
		1100	( )	225'	( )	Auto-Washer	( )
		1200	( )	250'	( )	Other	( )
		Other		Other			


NOTIFY HEALTH DEPARTMENT AT LEAST EIGHT HOURS BEFORE TANK IS TO BE INSPECTED.

Final Inspection MAY 22 1958

Approved (✓) Disapproved ( )

Remarks NO WATER ON PROPERTY

NOTIFIED FOR WASHER

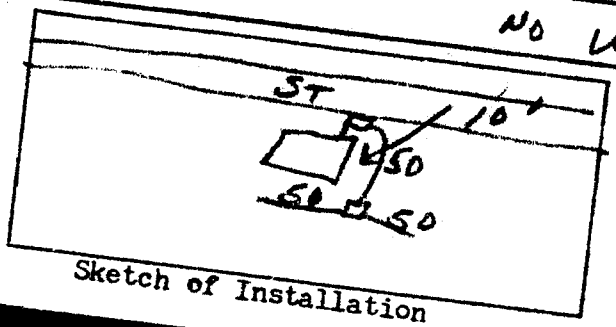

Sketch of Installation

Ralph A. Thomas

Sanitarian