IREDELL COUNTY HEALTH DEPARTMENT

ille Phone TR 3-7271 Mooresville Phone NO 3-1271

PERMIT TO INSTALL SEPTIC TANK

it NO._____ Permit Date MAY 22, 1952

ner E. B. COHEN Address STATESVILLE

Installed By C. HOKE Address _____

Location of Property OLD PARK DRIVE AT A&P GAS'S STORE 3RD HOUSE ON LEFT


Tank		Capacity		Length of Lines		Fixtures	
Block	( )	800	(✓)	150'	(✓)	No. of Baths	(1)
Precast	(✓)	900	( )	175'	( )	Dishwasher	( )
		1000	( )	200'	( )	Garbage Grdr.	( )
		1100	( )	225'	( )	Auto-Washer	( )
		1200	( )	250'	( )	Other	
		Other		Other			

NOTIFY HEALTH DEPARTMENT AT LEAST EIGHT HOURS BEFORE TANK IS TO BE INSPECTED.

Final Inspection MAY 22 1952 Approved (✓) Disapproved ( )

Remarks

10' STREET NO WATER ON PROPERTY

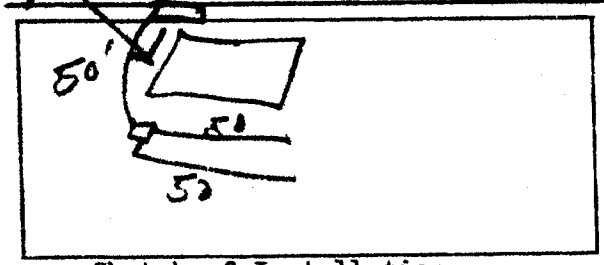

Sketch of Installation

NOT DESIGNED FOR WASHER

Raymond G. Thomas

Sanitarian