IREDELL COUNTY HEALTH DEPARTMENT

STATESVILLE 704-878-5305 MOORESVILLE 704-664-5281

IMPROVEMENT PERMIT / AUTHORIZATION TO CONSTRUCT / OPERATION PERMIT / EXISTING SYSTEM INSPECTION

PERMIT# Repair PIN# DATE 9/14/00

OWNER OR CONTRACTOR Hope Brothers PHONE: Business 872-4111 Home

ADDRESS 1120 North Barkley Road, Statesville, NC 28677

LOCATION 70W, Lt on Spiegle, Hse At Corner of Spiegle and Bristol – 2120 Bristol Drive

SUBDIVISION BLOCK / SECTION LOT LOT AREA SITE CLASS DESIGN FLOW L.T.A.R.

Septic Tank: 1000 Gallons: STB 1012 Date 1-26-01
Pump Tank: Gallons: PT Date
Pump Make: N/A Model Serial No.
Nitrification Field: No. Fields Square Feet Linear Feet
No Lines Trench Width Max Trench Bottom Depth Gravel Depth

☐ New System ☑ Repair System Type: I, II, III, IV, V, VI
System Description: Convalnd Sply
Repair System Description:
Maintenance Agreement Required: ☐ Yes ☑ No


☑ House/Mod. Home No. Bedrooms
☐ Mobile Home No. Bathrooms
☐ Business No. Employees
☐ Other
☐ Slab ☐ Crawl Space ☐ Basement w/plumbing ☐ Basement wo/plumbing

Water Supply: ☐ Individual ☑ Public ☐ Community


Comments/Conditions: Remove old tank and replace w/ new tank w filters/risers. Use Flow Divider Tee to access existg nitrification beds

Comments/Conditions:
- Poly Lok Filter Installed
- Septic Tank Risers Installed

INITIAL SITE SKETCH

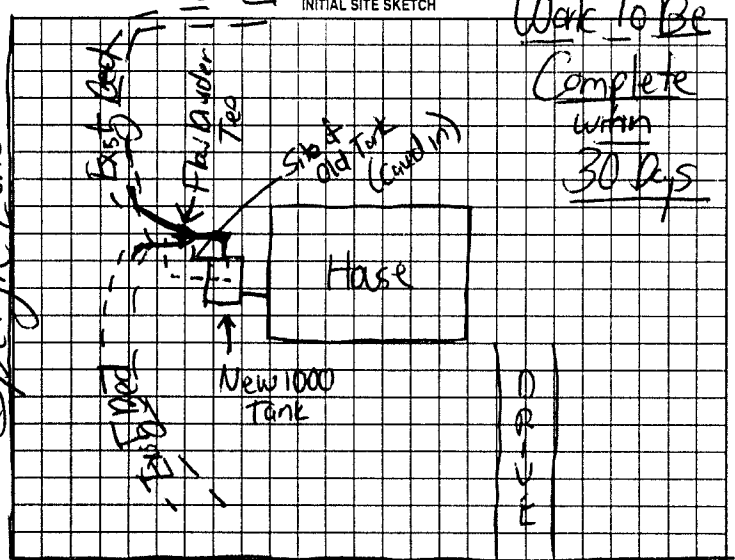

AS BUILT SKETCH

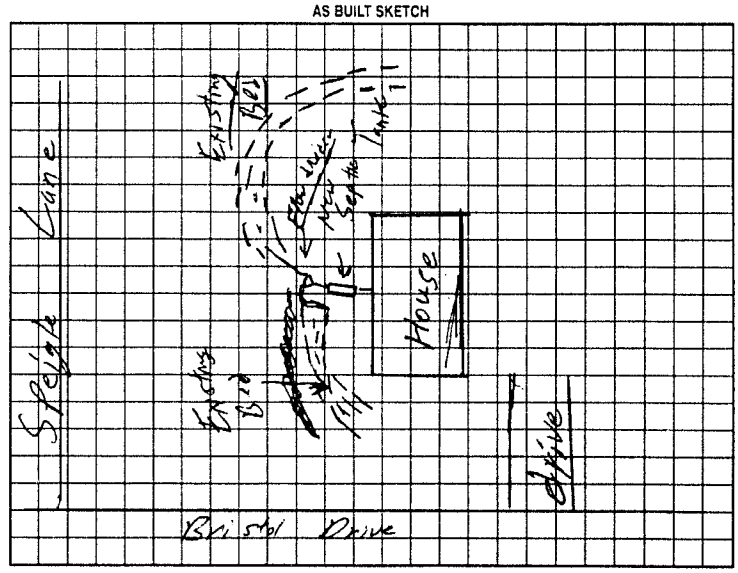

Permit can be suspended or revoked if any false information is supplied toward securing the permit/any unauthorized changes are made to the site/any unauthorized changes are made in the installation of the system. Improvement Permit with plat valid without expiration, Improvement Permit with site plan valid for sixty months. Authorization to Construct is valid for a period equal to that of Improvement Permit – not to exceed sixty months.

Signed: Joby Hope date 9-13-00 Installed by: John Hope

Improvement Permit by: date 9/14/00 Operation Permit by: William C. Johnson date 8/24/01

Authorization to Construct by: date 9/14/00 Existing System Inspection by: date

HEALTH DEPT. COPY: WHITE OWNER COPY (FINAL): YELLOW OWNER COPY (INITIAL): PINK