IREDELL COUNTY HEALTH DEPARTMENT

Statesville Phone TR 3-7271 Mooresville Phone NO 3-1271

PERMIT TO INSTALL SEPTIC TANK

Permit NO. [illegible] Permit Date Oct 12 1961

Owner Sherrill Lumber Co Address Statesville N.C.

Installed By Ross Sayer Address Statesville N.C.

Location of Property


Bristol Rd

Tank		Capacity		Length of Lines		Fixtures	
Block	( )	1000	(✓)	225'	(✓)	No. of Baths	( )
Precast	( )	1250	( )	250'	( )	Dishwasher	( )
		1500	( )	Other		Garbage Grdr.	( )
		Other				Other	

NOTIFY HEALTH DEPARTMENT AT LEAST EIGHT HOURS BEFORE TANK IS TO BE INSPECTED.

Final Inspection Oct 13 1961 Approved (✓) Disapproved ( )

Remarks

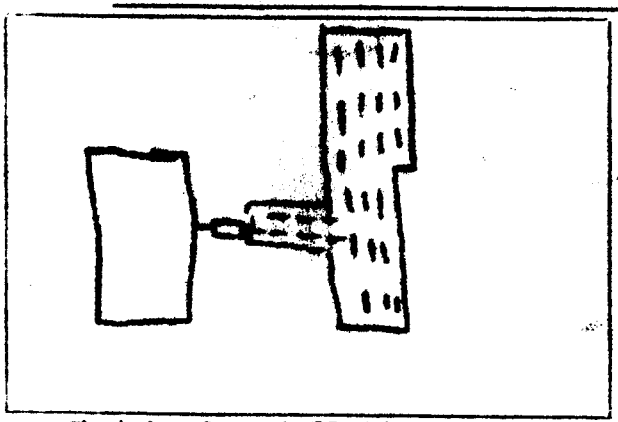

Sketch of Installation

Collins W Johnson R.S.

Sanitarian