IREDELL COUNTY HEALTH DEPARTMENT

STATESVILLE 704-878-5305 MOORESVILLE 704-664-5281

IMPROVEMENT PERMIT / AUTHORIZATION TO CONSTRUCT / OPERATION PERMIT / EXISTING SYSTEM INSPECTION

PERMIT# 083751 PIN# 4724 94 8204 DATE 9-29-00

OWNER OR CONTRACTOR LONNIE HARPER PHONE: Business Home 871-1484

ADDRESS 857 GRIER STREET STATESVILLE NC 28677

LOCATION US 70 WEST, TL GRIER ST 3RD HOUSE ON LEFT

SUBDIVISION BLOCK / SECTION LOT LOT AREA LIMITED SITE CLASS PS DESIGN FLOW 240 L.T.A.R. EXISTING

Septic Tank: EXISTING Gallons: STB Date
Pump Tank: Gallons: PT Date
Pump Make: Model Serial No.
Nitrification Field: No Fields Square Feet Linear Feet EXISTING
No Lines Trench Width Max Trench Bottom Depth Gravel Depth

☐ New System ☐ Repair System Type: I (II) III, IV, V, VI
System Description: CONVENTIONAL GRAVITY
Repair System Description:
Maintenance Agreement Required: ☐ Yes ☑ No
☑ Slab ☐ Crawl Space ☐ Basement w/plumbing ☐ Basement wo/plumbing

☐ House/Mod. Home No. Bedrooms
☐ Mobile Home No. Bathrooms 1
☐ Business No. Employees
☐ Other PRIVATE SHOP


Water Supply: ☐ Individual ☑ Public ☐ Community

Comments/Conditions:

Comments/Conditions: ① SYSTEM UNDERSIZED ACCORDING TO TODAY'S STANDARDS ② SHOP FOR PRIVATE USE ONLY - NO FLOOR DRAIN ALLOWED.

INITIAL SITE SKETCH

AS BUILT SKETCH SCALE: 1"=30'

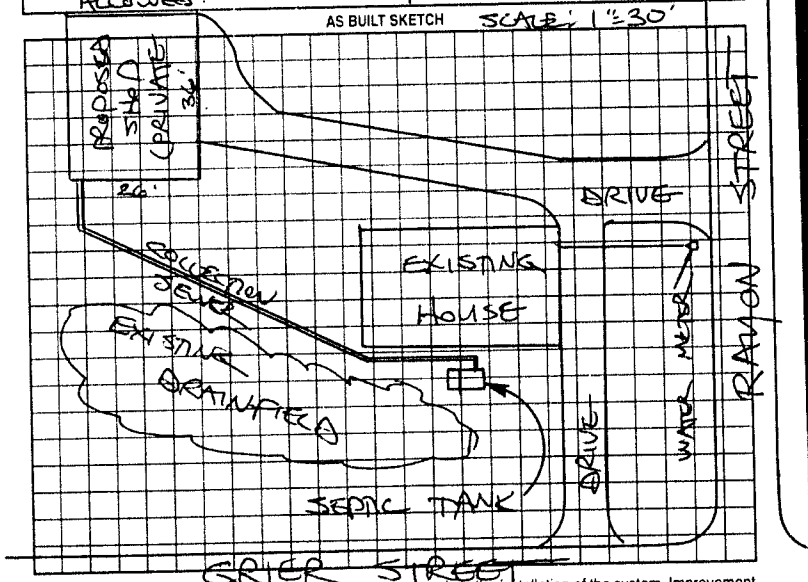

Permit can be suspended or revoked if any false information is supplied toward securing the permit/any unauthorized changes are made to the site/any unauthorized changes are made in the installation of the system. Improvement Permit with plat valid without expiration. Improvement Permit with site plan valid for sixty months. Authorization to Construct is valid for a period equal to that of Improvement Permit -- not to exceed sixty months.

Signed: date
Improvement Permit by: date
Authorization to Construct by: date

Installed by:
Operation Permit by: date
Existing System Inspection by: STEVE HEDRICK date 9-29-00

HEALTH DEPT COPY: WHITE OWNER COPY (FINAL): YELLOW OWNER COPY (INITIAL): PINK