IREDELL COUNTY HEALTH DEPARTMENT

STATESVILLE 704-878-5305 MOORESVILLE 704-664-5281

IMPROVEMENT PERMIT / AUTHORIZATION TO CONSTRUCT / OPERATION PERMIT / EXISTING SYSTEM INSPECTION

PERMIT# REPAIR PIN# 4724 94 9379 DATE 6-27-01

OWNER OR CONTRACTOR DAVID S. SMITH PHONE: Business Home (704) 873-3089

ADDRESS P.O. BOX 534, STATESVILLE, NC 28687

LOCATION US 70 WEST, TL GRIER STREET, TL GAGNOR STREET 3RD DWELLING ON RIGHT

SUBDIVISION BLOCK / SECTION LOT LOT AREA 100' x 150' SITE CLASS PS DESIGN FLOW 240 L.T.A.R. EXISTING

Septic Tank: EXISTING Gallons: STB Date

Pump Tank: Gallons: PT Date

Pump Make: Model Serial No

Nitrification Field: No Fields 1 Square Feet 390 Linear Feet 130

No Lines THREE Trench Width 36" Max Trench Bottom Depth 36"

☐ New System ☑ Repair System Type: I II III IV V VI

System Description: CONVENTIONAL GRAVITY

Repair System Description: CONV. GRAVITY

Maintenance Agreement Required: ☐ Yes ☑ No

Gravel Depth 18"

☐ Slab ☑ Crawl Space ☐ Basement w/plumbing ☐ Basement wo/plumbing

☐ House/Mod. Home ☑ Mobile Home ☐ Business ☐ Other


No. Bedrooms 2 No. Bathrooms 1 No. Employees

Water Supply: ☐ Individual ☑ Public ☐ Community

Comments/Conditions ① INSTALL THREE NEW LINES AS SHOWN USING 18" STONE ② KEEP SYSTEM MINIMUM 10' FROM WATER LINE

Comments/Conditions

INITIAL SITE SKETCH SCALE: 1" = 40'

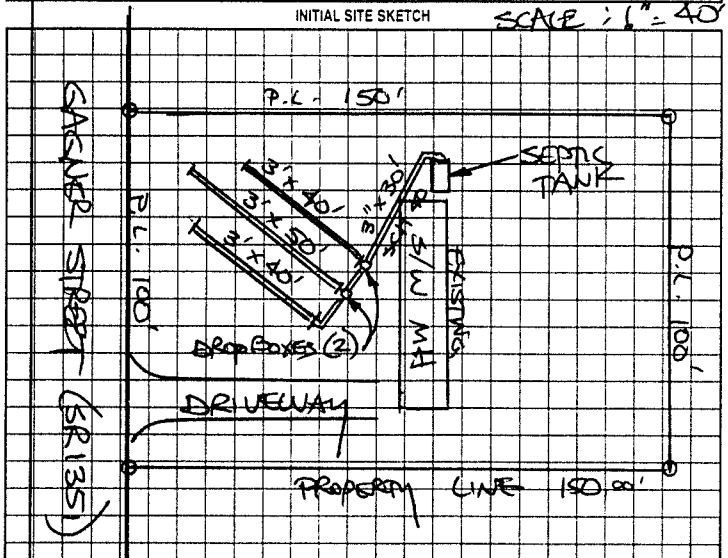

AS BUILT SKETCH

SYSTEM REPAIRED ACCORDING TO INITIAL SITE SKETCH

Permit can be suspended or revoked if any false information is supplied toward securing the permit/any unauthorized changes are made to the site/any unauthorized changes are made in the installation of the system. Improvement Permit with plat valid without expiration. Improvement Permit with site plan valid for sixty months. Authorization to Construct is valid for a period equal to that of Improvement Permit – not to exceed sixty months.

Signed: David S Smith 6-27-01 date Installed by: STEVE JORDAN

Improvement Permit by: STEVE HEDRICK date 6-27-01 Operation Permit by: STEVE HEDRICK date 6-29-01

Authorization to Construct by: STEVE HEDRICK date 6-27-01 Existing System Inspection by: date

HEALTH DEPT. COPY WHITE OWNER COPY (FINAL) YELLOW OWNER COPY (INITIAL) PINK