IREDELL COUNTY HEALTH DEPARTMENT

STATESVILLE 704-878-5305 MOORESVILLE 704-664-5281

IMPROVEMENT PERMIT / AUTHORIZATION TO CONSTRUCT / OPERATION PERMIT / EXISTING SYSTEM INSPECTION

PERMIT# REPAIR PIN# DATE 12-13-99

OWNER OR CONTRACTOR GLEN HENDRICK PHONE: Business Home 872-1594

ADDRESS 2234 CLINE STREET STATESVILLE, NC

LOCATION BARNER BARNEL BLVD TO WOOTEN ST, TL CRAIG ST, TL CLINE ST, LAST HOUSE ON LEFT

SUBDIVISION BLOCK / SECTION LOT LOT AREA LIMITED SITE CLASS P5 DESIGN FLOW 360 L.T.A.R. EXISTING

Septic Tank: EXISTING Gallons: STB Date

Pump Tank: Gallons: PT Date

Pump Make: Model Serial No.

Nitrification Field: No Fields 1 Square Feet 390 Linear Feet 130

No Lines ONE Trench Width 36" Max Trench Bottom Depth 36" Gravel Depth 18"

☐ New System ☑ Repair System Type: I (II) III IV V VI

System Description:

Repair System Description: CONVENTIONAL GRAVITY

Maintenance Agreement Required: ☐ Yes ☑ No

☑ House/Mod. Home ☐ Mobile Home ☐ Business ☐ Other

No. Bedrooms 3 No. Bathrooms 2 No. Employees


☐ Slab ☐ Crawl Space ☐ Basement w/plumbing ☑ Basement wo/plumbing

Water Supply: ☐ Individual ☑ Public ☐ Community

Comments/Conditions: (1) INSTALL NEW SANITARY TEE IN TANK IF NECESSARY (2) INSTALL NEW 3" SCH 40 PVC PIPE AND TWO NEW DROP BOXES AS SHOWN (3) USE 18" STONE IN NEW 3' X 130' LINE

Comments/Conditions: THIS PERMIT SERVES AS NOTICE OF VIOLATION - SYSTEM TO BE REPAIRED BY 1-15-2000

INITIAL SITE SKETCH SCALE: 1" = 40'

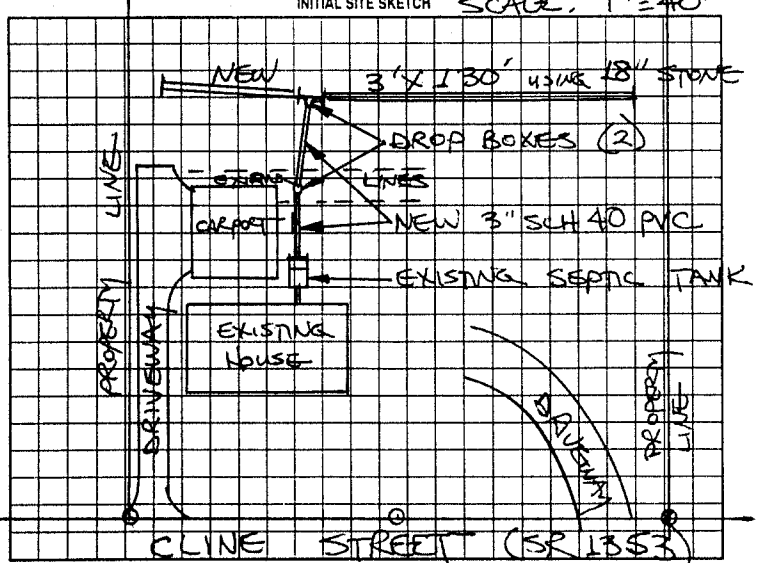

AS BUILT SKETCH

SYSTEM REPAIRED ACCORDING TO INITIAL SITE SKETCH

Permit can be suspended or revoked if any false information is supplied toward securing the permit/any unauthorized changes are made to the site/any unauthorized changes are made in the installation of the system. Improvement Permit with plat valid without expiration. Improvement Permit with site plan valid for sixty months. Authorization to Construct is valid for a period equal to that of Improvement Permit – not to exceed sixty months.

Signed: T Hickman & Hedrick date 12-13-99 Installed by: JAMES HUDLER

Improvement Permit by: STEVE HEDRICK date 12-13-99 Operation Permit by: STEVE HEDRICK date 12-29-99

Authorization to Construct by: STEVE HEDRICK date 12-13-99 Existing System Inspection by: date

HEALTH DEPT. COPY: WHITE OWNER COPY (FINAL): YELLOW OWNER COPY (INITIAL): PINK