IREDELL COUNTY HEALTH DEPARTMENT

Statesville Phone TR 3-7271 Mooresville Phone NO 3-1271

PERMIT TO INSTALL SEPTIC TANK

Permit NO. _____ Permit Date Nov 26 1965

Owner Mrs. S.C. Cline - Address Sullivan Rd City.

Installed By C Hoke Address R7 -


Location of Property W.J. Corley - 2247 Cline St.
behind Villa Hgts Drive-in Theater

Tank		Capacity		Length of Lines		Fixtures	
Block	( )	1000	(+)	225'	(+)	No. of Baths	(1)
Precast	(+)	1250	( )	250'	( )	Dishwasher	( )
		1500	( )	Other _____		Garbage Grdr.	( )
		Other _____				Other tenant ho.	

NOTIFY HEALTH DEPARTMENT AT LEAST EIGHT HOURS BEFORE TANK IS TO BE INSPECTED.

Final Inspection _____ 19__ Approved ( ) Disapproved ( )

Remarks city water - 75 ft lot very narrow

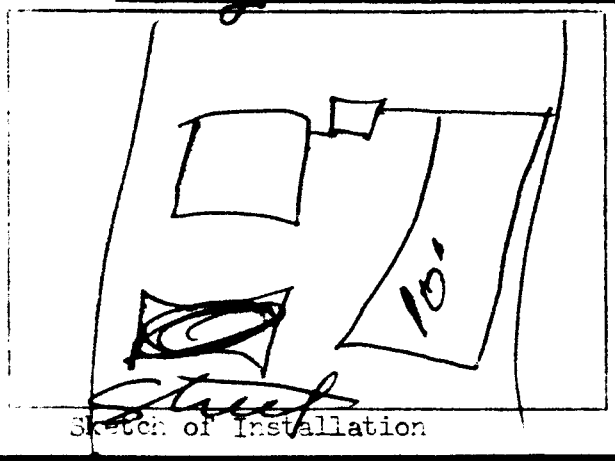

Sketch of Installation

R W [illegible]

Sanitarian