IREDELL COUNTY HEALTH DEPARTMENT

Statesville Phone TR 3-7271 Mooresville Phone NO 3-1271

PERMIT TO INSTALL SEPTIC TANK

Permit NO. _____ Permit Date May 2 - 1961

Owner Villa Heights Theater Address Off Hickory Hwy

Installed By C Hoke Address RT.


Location of Property theater off Hickory Hwy - at city limits

Tank		Capacity		Length of Lines		Fixtures	
Block	( )	800	( )	150'	( )	No. of Baths	(2)
Precast	(✓)	900	( )	175'	( )	Dishwasher	( )
		1000	(✓)	200'	( )	Garbage Grdr.	( )
		1100	( )	225'	( )	Auto-Washer	( )
Lock		1200	( )	250'	( )	Other Snack Bar.	
		Other _____		Other 300'			

NOTIFY HEALTH DEPARTMENT AT LEAST EIGHT HOURS BEFORE TANK IS TO BE INSPECTED.

Final Inspection May 2 1961 Approved (✓) Disapproved ( )

Remarks New tank & lines to replace existing lay out which was fouled up -

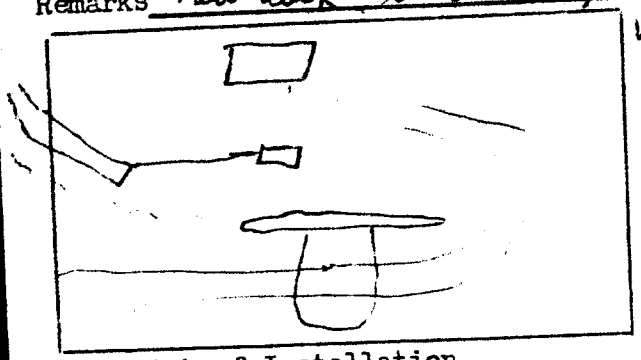

Sketch of Installation

checked by Thomas E Johnson RT.

Sanitarian