See attached permit #163953 for carport.

IREDELL COUNTY HEALTH DEPARTMENT

STATESVILLE 704-878-5305 MOORESVILLE 704-664-5281

IMPROVEMENT PERMIT / AUTHORIZATION TO CONSTRUCT / OPERATION PERMIT / EXISTING SYSTEM INSPECTION

PERMIT# REPAIR PIN# 4729-95-8619 DATE 4-3-07

OWNER OR APPLICANT JOHN THOMAS ALEXANDER III PHONE: Business 704-500-6717 Home 704-876-6691

ADDRESS 372 BAY MOUNT DRIVE, STATESVILLE, NC 28625-9540

LOCATION GARNER BAGNAL BLVD TO WOOTEN STREET, TL CRAIG ST, TL PS CLINE ST, 3RD HOUSE ON RIGHT (2239)

SUBDIVISION ACE INVESTMENT BLOCK / SECTION ____ LOT 1 LOT AREA 0.92 ACRE SITE CLASS. PS DESIGN FLOW 360 L.T.A.R. 0.30 GRAVITY

Septic Tank: EXISTING Gallons: STB ____ Date ____

Pump Tank: ____ Gallons: PT ____ Date ____

Pump Make: ____ Model ____ Serial No. ____

Nitrification Field: No. Fields 1 Square Feet 1600 Linear Feet 300

No. Lines FOUR Trench Width 36" Max Trench Bottom Depth 36"

☐ New System ☑ Repair ☐ Expansion System Type: I II III IV V VI

System Description: CONVENTIONAL

Repair System Description: 25% REDUCTION, GRAVITY

Maintenance Agreement Required: ☐ Yes ☑ No

Gravel Depth N/A ☑ Gravity ☐ Pressure

☑ House/Mod. Home ☐ Mobile Home ☐ Business ☑ Other

No. Bedrooms 2 No. Persons ____ No. Employees ____


Water Supply: ☐ Individual ☑ Public ☐ Community

☐ Slab ☑ Crawl Space ☐ Basement w/plumbing ☐ Basement wo/plumbing

Comments/Conditions: ① KEEP SYSTEM MINIMUM FIVE (5) FEET FROM PROPERTY LINE ② INSTALL NEW 25% REDUCTION SYSTEM USING SERIAL DISTRIBUTION AS SHOWN.

Comments/Conditions: ③ SYSTEM TO BE REPAIRED BY MAY 4, 2007

INITIAL SITE SKETCH

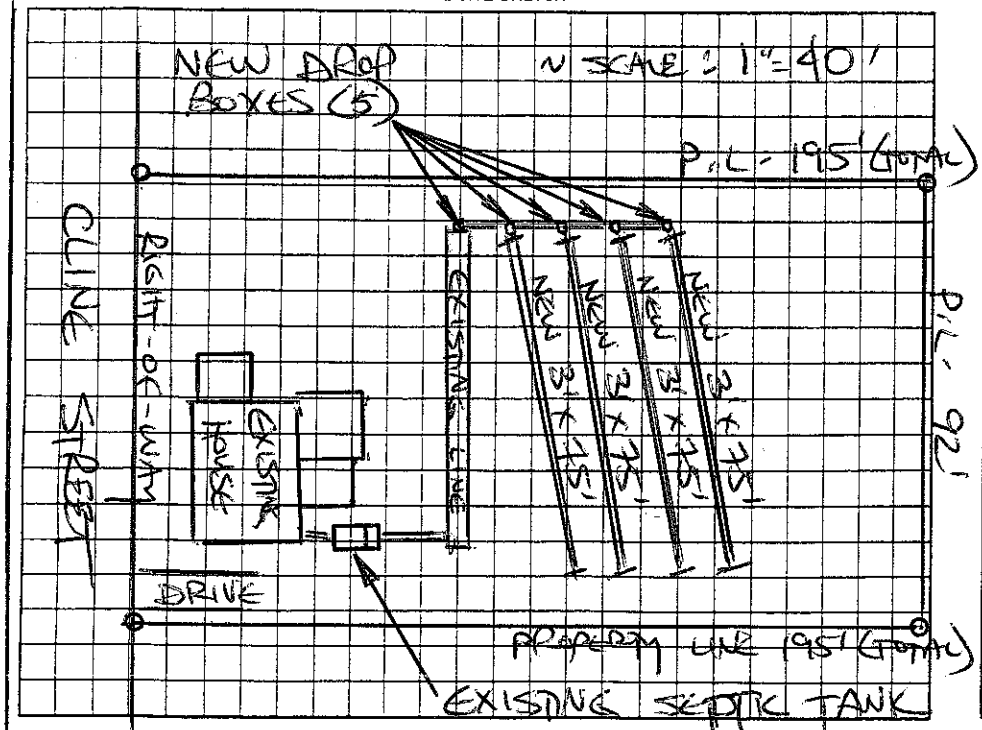

AS BUILT SKETCH

SYSTEM REPAIRED ACCORDING TO INITIAL SITE SKETCH

Permit can be suspended or revoked if any false information is supplied toward securing the permit/any unauthorized changes are made to the site/any unauthorized changes are made in the installation of the system. Improvement Permit with plat valid without expiration ☐ Improvement Permit with site plan valid for sixty months ☑ Authorization to Construct is valid for a period equal to that of Improvement Permit – not to exceed sixty months.

Signed: Caroline Alexander date 4-4-07

Improvement Permit by: STEVE HEDRICK date 4-3-07

Authorization to Construct by: STEVE HEDRICK date 4-3-07

Installed by: A-1 BACKHOE

Operation Permit by: STEVE HEDRICK date 5-16-07

Existing System Inspection by: ____ date ____

HEALTH DEPT. COPY: WHITE OWNER COPY (FINAL): YELLOW OWNER COPY (INITIAL): PINK