IREDELL COUNTY HEALTH DEPARTMENT

STATESVILLE 704-878-5305 MOORESVILLE 704-664-5281

IMPROVEMENT PERMIT / AUTHORIZATION TO CONSTRUCT / OPERATION PERMIT / EXISTING SYSTEM INSPECTION

PERMIT# REPAIR PIN# 4729-95-8619 DATE 4-3-07

OWNER OR APPLICANT JOHN THOMAS ALEXANDER III PHONE: Business 704-500-6717 Home 704-876-6691

ADDRESS 372 BAYMOUNT DRIVE, STATESVILLE, NC 28625-9540

LOCATION GARNER BAGNAL BLVD TO WOOTEN STREET, TL CRAIG ST, TL PS CLINE ST, 3RD HOUSE ON RIGHT (2239)

SUBDIVISION ACE INVESTMENT BLOCK / SECTION ____ LOT 1 LOT AREA 0.42 ACRE SITE CLASS. 1 DESIGN FLOW 360 L.T.A.R. 0.30 GRAVITY

Septic Tank: EXISTING Gallons: STB ____ Date ____

Pump Tank: ____ Gallons: PT ____ Date ____

Pump Make: ____ Model ____ Serial No. ____

Nitrification Field: No. Fields 1 Square Feet 1600 Linear Feet 300

No. Lines FOUR Trench Width 36" Max Trench Bottom Depth 36"

☐ New System ☑ Repair ☐ Expansion System Type: I II III IV V VI

System Description: CONVENTIONAL

Repair System Description: 25% REDUCTION, GRAVITY

Maintenance Agreement Required: ☐ Yes ☑ No

☑ House/Mod. Home No. Bedrooms 2

☐ Mobile Home No. Persons ____

☐ Business No. Employees ____

☑ Other ____


Water Supply: ☐ Individual ☑ Public ☐ Community

Gravel Depth N/A ☑ Gravity ☐ Pressure ☐ Slab ☑ Crawl Space ☐ Basement w/plumbing ☐ Basement wo/plumbing

Comments:/Conditions: ① KEEP SYSTEM MINIMUM FIVE (5) FEET FROM PROPERTY LINE ② INSTALL NEW 25% REDUCTION SYSTEM USING SERIAL DISTRIBUTION AS SHOWN.

Comments:/Conditions: ③ SYSTEM TO BE REPAIRED BY MAY 4, 2007

INITIAL SITE SKETCH

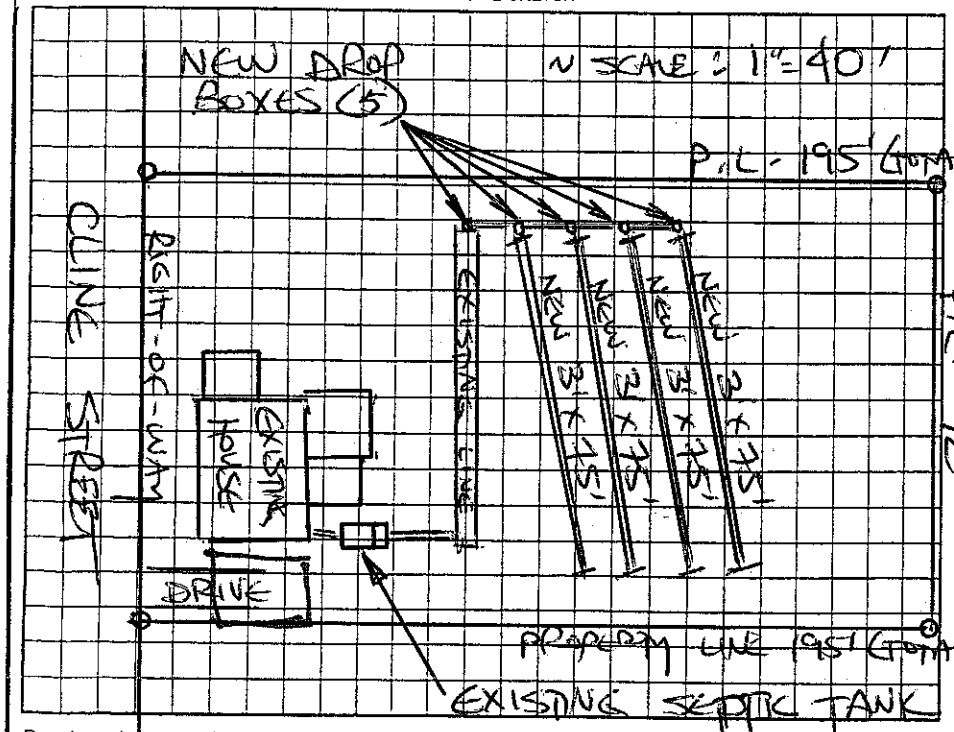

AS BUILT SKETCH

SYSTEM REPAIRED ACCORDING TO INITIAL SITE SKETCH

The location of the proposed carport (18×21) addition does not appear to impact the existing septic system.

**NOTE: ____

REHS

Date: 10-22-10

ICHD-Environmental Health Division

Permit can be suspended or revoked if any false information is supplied toward securing the permit/any unauthorized changes are made to the site/any unauthorized changes are made in the installation of the system. Improvement Permit with plat valid without expiration ☐ Improvement Permit with site plan valid for sixty months ☑ Authorization to Construct is valid for a period equal to that of Improvement Permit – not to exceed sixty months.

Signed: Christina Alexander date 4-4-07

Improvement Permit by: STEVE HEDRICK date 4-3-07

Authorization to Construct by: STEVE HEDRICK date 4-3-07

Installed by: A-1 BACKHOE

Operation Permit by: STEVE HEDRICK date 5-16-07

Existing System Inspection by: ____ date ____

HEALTH DEPT. COPY: WHITE OWNER COPY (FINAL): YELLOW OWNER COPY (INITIAL): PINK