IREDELL COUNTY HEALTH DEPARTMENT

Statesville Phone TR 3-7271 — Mo[illegible]esville Phone NO 3-1271

PERMIT TO INSTALL SEPTIC TANK

Permit NO. _____ TESTING LAB. Permit Date 7/25 1962

Owner S. H. & P. W. C. Address STATESVILLE, NC

Installed By SELF Address METAL BLD.


Location of Property BEHIND THE COCA COLA PLANT

Tank		Capacity		Length of Lines		Fixtures	
Block	( )	800	( )	150'	( )	No. of Baths	(1)
Precast	(✓)	900	( )	175'	( )	Dishwasher	( )
		1000	(✓)	200'	( )	Garbage Grdr.	( )
		1100	( )	225'	(✓)	Auto-Washer	( )
		1200	( )	250'	( )	Other	
		Other		Other			

NOTIFY HEALTH DEPARTMENT AT LEAST EIGHT HOURS BEFORE TANK IS TO BE INSPECTED.

Final Inspection 7/25 1962 Approved (✓) Disapproved ( )

Remarks

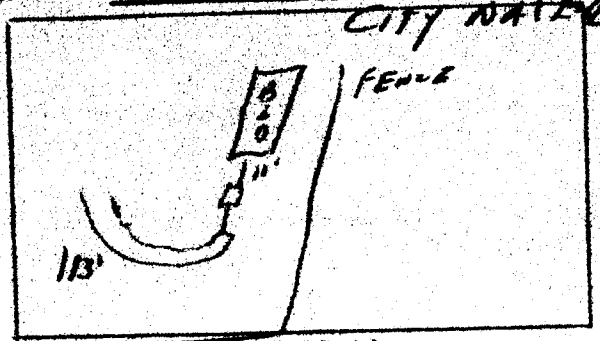

Sketch of Installation

Rt.

Sanitarian