IREDELL COUNTY HEALTH DEPARTMENT

Statesville Phone TR 3-7271 Mooresville Phone NO 3-1271

PERMIT TO INSTALL SEPTIC TANK

Permit NO. _____ Permit Date 3-17 1959

Owner Lowes Assoates Inc. Address #90

Installed By C Hoke Address R7


Location of Property Above "Coke" Plant on #90

Tank		Capacity		Length of Lines		Fixtures	
Block	( )	800	(✓)	150'	(✓)	No. of Baths	(2)
Precast	(✓)	900	( )	175'	( )	Dishwasher	( )
		1000	( )	200'	( )	Garbage Grdr.	( )
		1100	( )	225'	( )	Auto-Washer	( )
		1200	( )	250'	( )	Other	
		Other		Other			

NOTIFY HEALTH DEPARTMENT AT LEAST EIGHT HOURS BEFORE TANK IS TO BE INSPECTED.

Final Inspection 3-17 1959 Approved (✓) Disapproved ( )

Remarks To change to sewer later on - City water

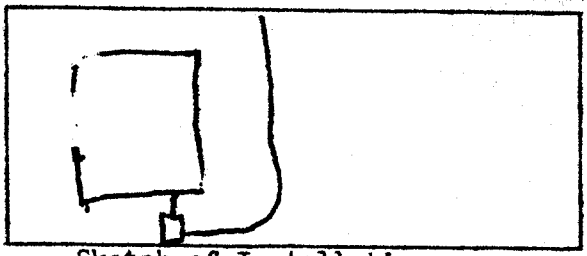

Sketch of Installation

Sanitarian