IREDELL COUNTY HEALTH DEPARTMENT

STATESVILLE 704-878-5305 MOORESVILLE 704-664-5281

IMPROVEMENT PERMIT / CERTIFICATE OF COMPLETION / OPERATION PERMIT / EXISTING SYSTEM INSPECTION

PROPERTY DESCRIPTION NO. 19074 DATE 9-14-94 TAX MAP NO. 9D-1-B-69 Watershed: ☐ Yes ☑ No

OWNER OR CONTRACTOR Johnny M. Wyatt Jr. PHONE: Business _____ Home 873-3896

ADDRESS Rt. 13 Box 395 Statesville, N.C. 28677

LOCATION I40W TO Hwy 90 TL Absher Farm Rd. Behind 3rd Brick house on R.

SUBDIVISION NA BLOCK / SECTION NA LOT NA LOT AREA ±2.0 acres SITE CLASS. P.S. DESIGN FLOW 360. L.T.A.R. .3gpd/ft²

Septic Tank: 1000 Gallons; STB 1012 Date 7-12-94
Pump Tank: — Gallons; PT — Date —
Pump Make: — Model — Serial No. —
Nitrification Field: No Fields 2 Square Feet 900 Linear Feet 300'
No Lines 5 Trench Width 36" Max Trench Bottom Depth 24" Gravel Depth 12"

☐ New System ☑ Repair System Type: I, (II) III, IV, V, VI
System Description: conventional, gravity fed
Repair System Description: PPBPS
Maintenance Agreement Required: ☐ Yes ☑ No


☐ House/Mod. Home ☑ Mobile Home ☐ Business ☑ Other Adding to septic system of Building to be converted to 3 Bedroom Home
No. Bedrooms 3 No. Bathrooms 2 No. Employees _____
☐ Slab ☑ Crawl Space ☐ Basement w/plumbing ☐ Basement wo/plumbing

Water Supply: ☑ Individual ☐ Community ☐ Public share well with house

Comments: Set new tank or move existing tank. Install 300' of drainlines and tie into existing drainline. INSTALL NEW LINES SHALLOW (no deeper than 24" to bottom of trench.) Keep lines on contour. Keep system 10' from all property lines, 5' min from foundation of home, 50' from well, and keep system out of existing surface diversion ditch. Keep water line 10' from any part of septic system.

Comments: Set New tank and plumbed into existing tank instead of ~~Existing~~ D-box Home not located at time of inspection. Keep home min 5' from any part of septic system. Water line not run, Keep it 10' from any part of septic system.

INITIAL SITE SKETCH

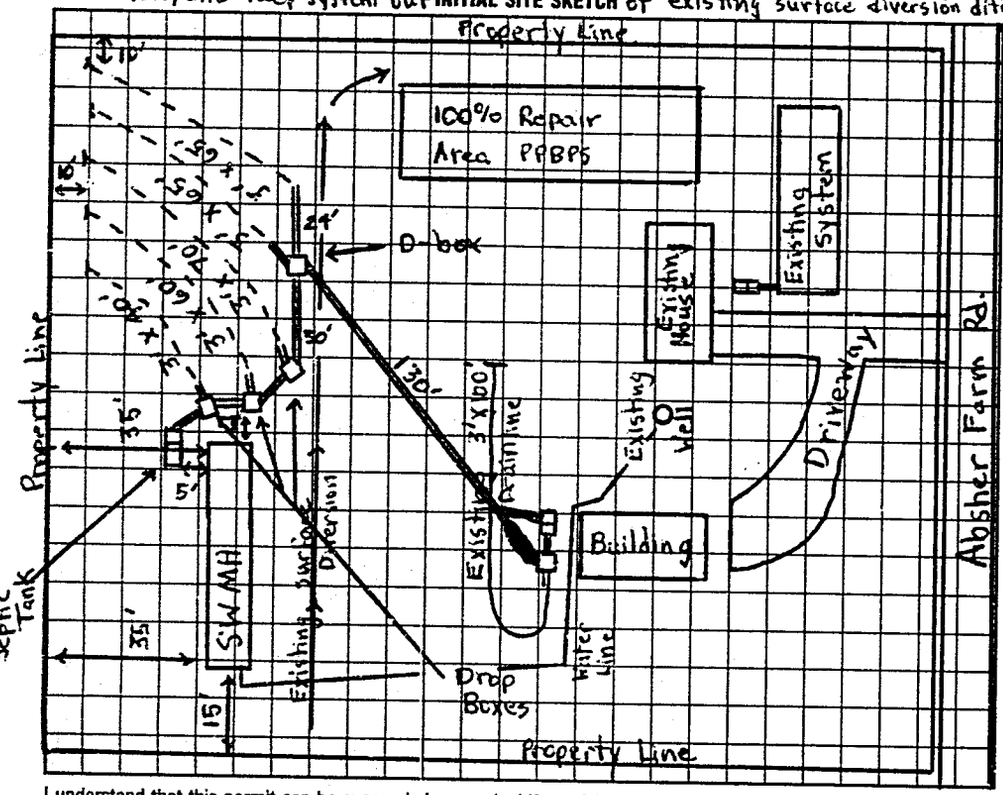

AS BUILT SKETCH

part of septic system.
100% Repair in side yard
PPBPS.

* Joe Lynn, Reginal soils specialist reviewed lot and gave this recommendation.

* Plumbing from building to be disconnected.

SAME AS INITIAL SKETCH

I understand that this permit can be suspended or revoked if any false information is supplied toward securing the permit/any unauthorized changes are made to the site/any unauthorized changes are made in the installation of the system. Improvement Permit is valid for 60 months from date of issuance.

Signed: _____

Improvement Permit by: Michael J. Dennis date 9-14-94

Existing System Inspection by: _____ date _____

Installed by: JAMES HUDLER

Certificate of Completion by: Michael J. Dennis date 10-4-94

Operation Permit by: _____ date _____

HEALTH DEPT. COPY: WHITE INSPECTION COPY (FINAL): GREEN OWNER COPY (FINAL): YELLOW INSPECTION COPY (INITIAL): PINK OWNER COPY (INITIAL): GOLD