IREDELL COUNTY HEALTH DEPARTMENT - *ENVIRONMENTAL HEALTH* ☐ STATESVILLE OFFICE 704-878-5305 ☐ MOORESVILLE OFFICE 704-664-5281

IMPROVEMENT PERMIT / AUTHORIZATION TO CONSTRUCT / OPERATION PERMIT / EXISTING SYSTEM INSPECTION

PERMIT # Repair PIN # 4785-06-4054 DATE 25 January 2011

OWNER Monticello UMC APPLICANT: PHONE: Home/Cell # Business # (704) 924-8322

SITE ADDRESS 3639 Taylorsville Hwy OWNER / APPLICANT ADDRESS

SITE DIRECTIONS Hwy 90 From Statesville on left past Monticello Baptist Church.

SUBDIVISION BLOCK / SECTION LOT # LOT AREA 0.53 Ac. DESIGN FLOW 360 gpd L.T.A.R. 0.3 gpd/ft²

Septic Tank 1000 Gallons: STB 1012 Date 1-21-10 ☐ New System ☑ Repair ☐ Expansion System Type I II (III) IV V VI

Pump Tank Gallons: P T Date System Description:

Pump Make Model Serial # Repair System Description: 50% Reduction

No. Nitrification Fields: 1 No. Lines 6 Linear Feet 240 Maintenance Agreement Required ☐ YES ☑ NO

Trench Width 24" Max. Trench Bottom Depth 36" Gravel Depth N/A ☑ GRAVITY ☐ PRESSURE


☑ Residence No. Bedrooms 3 ☐ Business No. Persons ☐ Other No. Employees ☐ Slab ☑ Crawl Space ☐ Basement w/plumbing ☐ Basement w/o plumbing

Water Supply: ☑ Private ☐ Public ☐ Community


Comments / Conditions 54 panels - 9 per line.
* Remove 2 large maple trees in front yard.

* All available area utilized for repair system. Property deeded prior to 1983. -.1945 C.

INITIAL SITE SKETCH

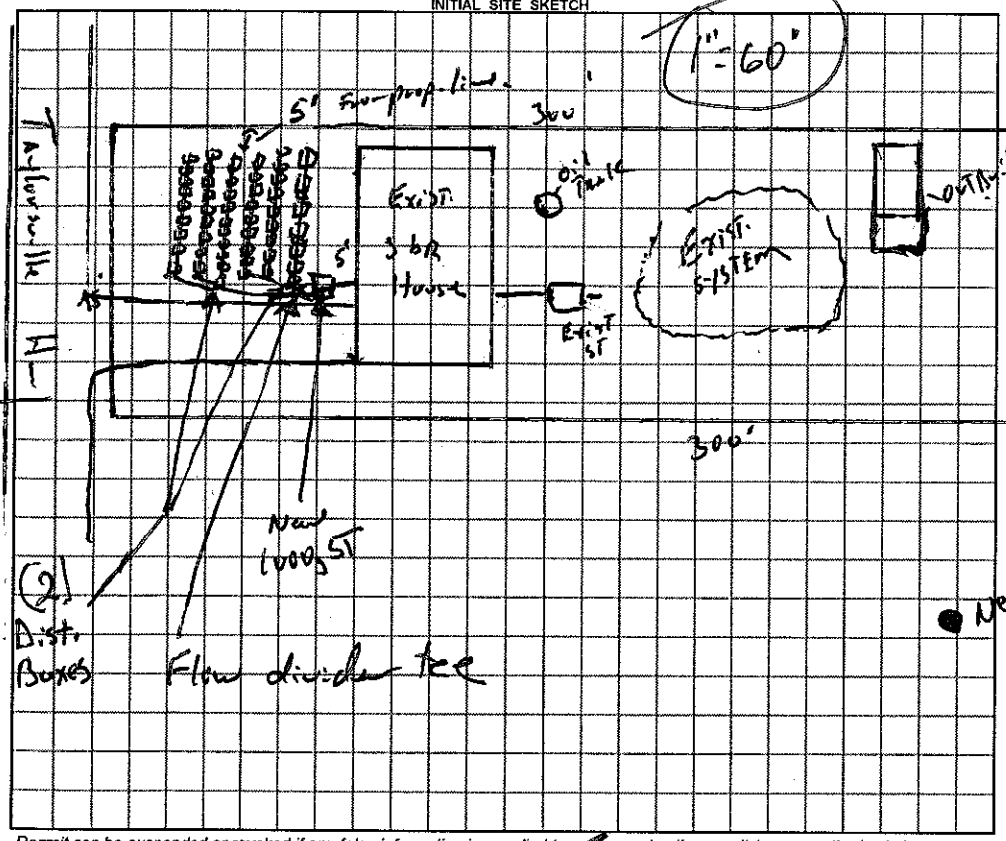

AS BUILT SKETCH

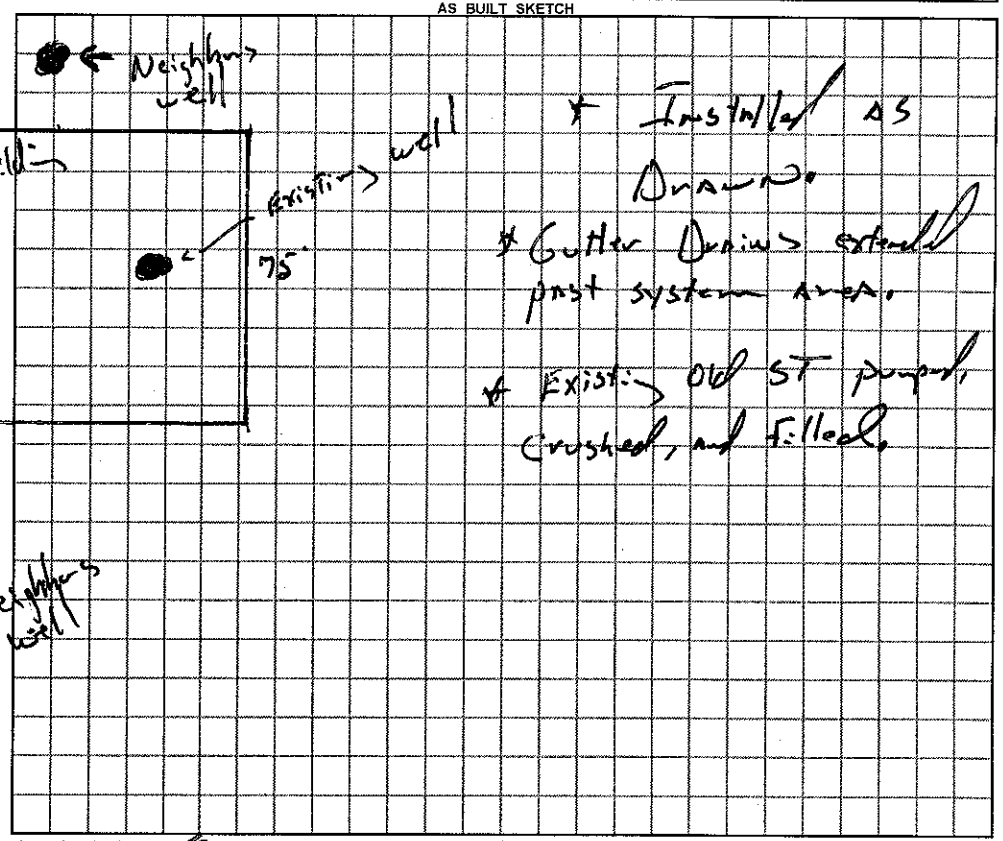

Permit can be suspended or revoked if any false information is supplied towards securing the permit / any unauthorized changes are made to the site / any unauthorized changes are made in the installation of the system.

☐ ***IMPROVEMENT PERMIT*** with plat valid without expiration. ☑ ***IMPROVEMENT PERMIT*** with plat valid ~~without expiration~~. ☑ ***AUTHORIZATION TO CONSTRUCT*** valid for period equal to IMPROVEMENT PERMIT--not to exceed 60 mo.

Owner / Applicant Signature: Date 2-4-11 (60 mos.) Installed by: Wes Litton

IMPROVEMENT PERMIT by: REHS Date 27 Jan. 11 OPERATION PERMIT by: REHS Date 23 March 11

AUTHORIZATION TO CONSTRUCT by: REHS Date 27 Jan. 11 Existing System Inspected by: REHS Date

YOU SHOULD CONTACT A LOCATOR SERVICE PRIOR TO ANY EXCAVATION

White Copy – Environmental Health YELLOW COPY (Final) Owner / Applicant PINK COPY (Initial) Owner / Applicant