IREDELL COUNTY HEALTH DEPARTMENT

STATESVILLE 704-878-5305 CI MOORESVILLE 704-664-5281

IMPROVEMENT PERMIT / AUTHORIZATION TO CONSTRUCT / OPERATION PERMIT / EXISTING SYSTEM INSPECTION

(C1)

PERMIT# 107875 PIN# 4715-98-6382.B DATE 8-7-02

OWNER OR CONTRACTOR DORIS WEST PHONE Business (RAH) 704-924-8942 Home

ADDRESS 218 WEST BROAD ST, STATESVILLE, NC 28677

LOCATION NC 90 WEST TR DEER RIDGE LANE BEAR RIGHT, 1ST MOBILE HOME ON LEFT

SUBDIVISION BLOCK / SECTION LOT LOT AREA 173.48 Ac SITE CLASS IS DESIGN FLOW 360 L.T.A.R. 0.30 GPD/FT2

Septic Tank: 1000 Gallons: STB 1007 Date 7-8-02
Pump Tank: Gallons: PT Date
Pump Make: Model Serial No
Nitrification Field: No Fields 1 Square Feet 1200 Linear Feet 400
No Lines FOUR Trench Width 36" Max Trench Bottom Depth 36" Gravel Depth 12"

☑ New System ☐ Repair System Type: I (II) III IV V VI
System Description: CONVENTIONAL GRAVITY
Repair System Description: CONVENTIONAL GRAVITY
Maintenance Agreement Required: ☐ Yes ☑ No
☐ Slab ☑ Crawl Space ☐ Basement w/plumbing ☐ Basement wo/plumbing


☑ House/Mod. Home ☐ Mobile Home ☐ Business ☐ Other
No. Bedrooms 3 No. Bathrooms 2 No. Employees

Water Supply: ☑ Individual ☐ Public ☐ Community WELL


Comments/Conditions: KEEP SYSTEM MINIMUM 100 FEET FROM WELL

Comments/Conditions - Polylok Filter Installed

INITIAL SITE SKETCH

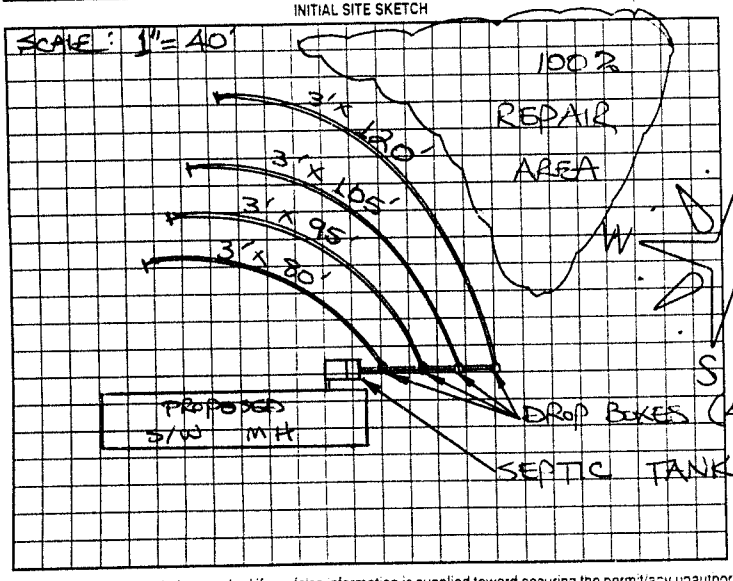

AS BUILT SKETCH

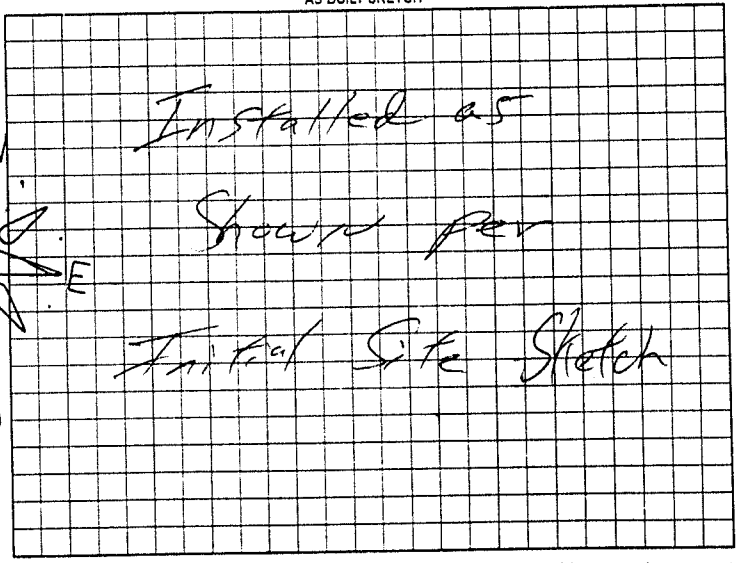

Permit can be suspended or revoked if any false information is supplied toward securing the permit/any unauthorized changes are made to the site any unauthorized changes are made in the installation of the system. Improvement Permit with plat valid without expiration. Improvement Permit with site plan valid for sixty months. Authorization to Construct is valid for a period equal to that of Improvement Permit – not to exceed sixty months

Signed: Tommy Gilbert date 8/7/02 Installed by Henry Pearson

Improvement Permit by: STEVE HENDRICK date 8-7-02 Operation Permit by: William O. Johnson date 9/12/02

Authorization to Construct by: STEVE HENDRICK date 8-7-02 Existing System Inspection by: date

HEALTH DEPT COPY WHITE OWNER COPY (FINAL) YELLOW OWNER COPY (INITIAL) PINK