IREDELL COUNTY HEALTH DEPARTMENT

STATESVILLE 704-878-5305 MOORESVILLE 704-664-5281

IMPROVEMENT PERMIT / CERTIFICATE OF COMPLETION / OPERATION PERMIT / EXISTING SYSTEM INSPECTION

PROPERTY DESCRIPTION NO. 70556 DATE 12-12-97 TAX MAP NO. 4715986382 Watershed: ☐ Yes ☐ No

OWNER OR CONTRACTOR Doris West PHONE: Business _____ Home _____

ADDRESS Po Box 751 Statesville N.C.

LOCATION Hwy 90 West TR across Alex RR Just beyond Abshire Fm Loop 1/4mi back(LT) (TR) (Deer Field Ln)

SUBDIVISION West Farm BLOCK / SECTION _____ LOT _____ LOT AREA 174 acres SITE CLASS: PS DESIGN FLOW 360 L.T.A.R. 133

Septic Tank: 1000 Gallons; STB 10-12 Date 11-10-97

Pump Tank: _____ Gallons; PT _____ Date _____

Pump Make: _____ Model _____ Serial No. _____

Nitrification Field: No Fields 1 Square Feet 1080 Linear Feet 360

No Lines 4 Trench Width 36" Max Trench Bottom Depth 36" Gravel Depth 12"

☑ New System ☐ Repair System Type: I, II, III, IV, V, VI

System Description: Conv. Gravity

Repair System Description: " "

Maintenance Agreement Required: ☐ Yes ☑ No

☐ House/Mod. Home No. Bedrooms 3

☑ Mobile Home No. Bathrooms 2

☐ Business No. Employees _____

☐ Other _____


☐ Slab ☑ Crawl Space ☐ Basement w/plumbing ☐ Basement wo/plumbing

Water Supply: ☑ Individual ☐ Community ☐ Public


Comments:

Comments:

INITIAL SITE SKETCH

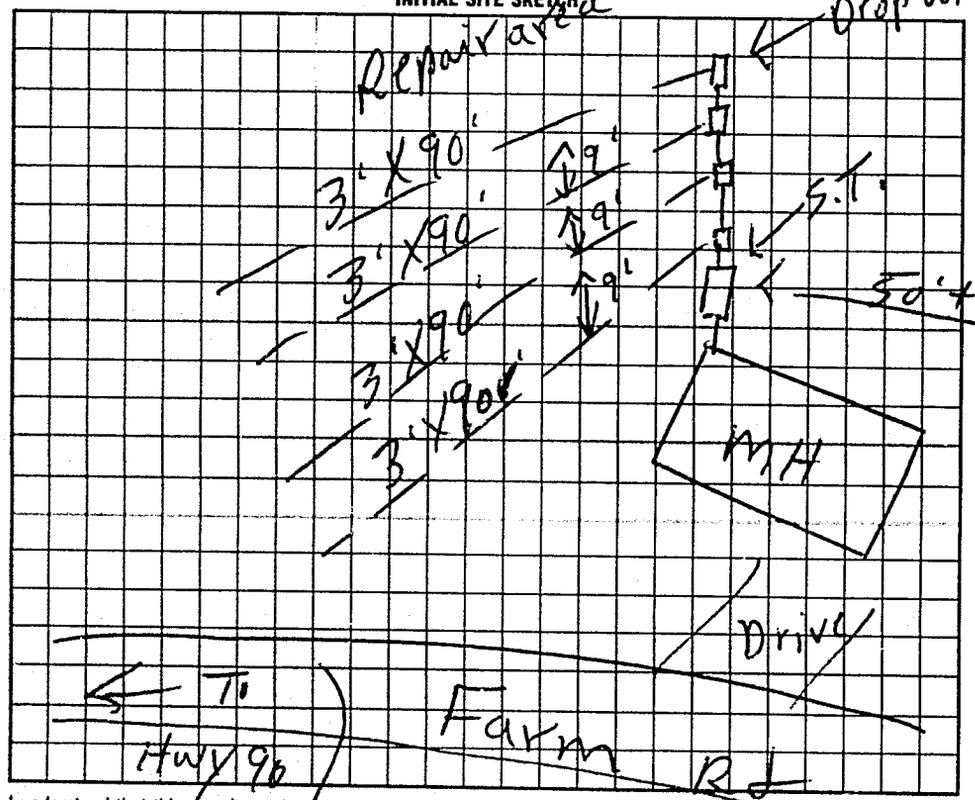

AS BUILT SKETCH

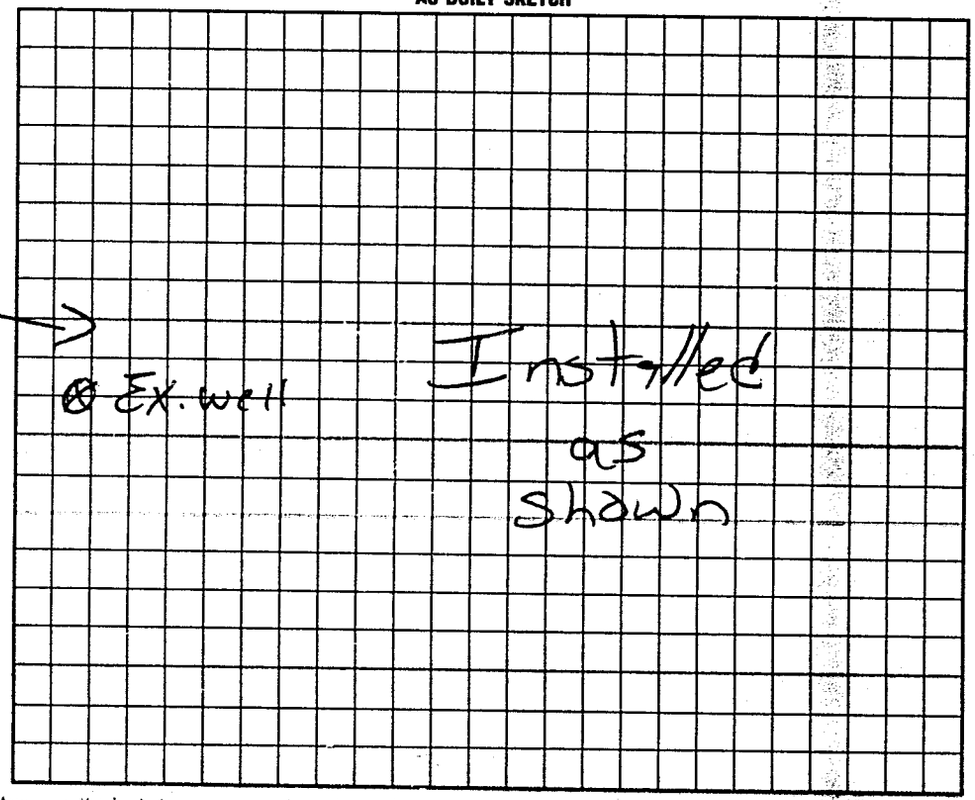

I understand that this permit can be suspended or revoked if any false information is supplied toward securing the permit/any unauthorized changes are made to the site/any unauthorized changes are made in the installation of the system. Improvement Permit is valid for 60 months from date of issuance.

Signed: X _____

Improvement Permit by: P.C. Moore date 12-12-97

Existing System Inspection by: P.C. Moore date 12-12-97

Installed by: Tommy Frye

Certificate of Completion by: _____ date _____

Operation Permit by: Mark Coffey RS date 2-26-98

Authorization to cont

HEALTH DEPT. COPY: WHITE INSPECTION COPY (FINAL): GREEN OWNER COPY (FINAL): YELLOW INSPECTION COPY (INITIAL): PINK OWNER COPY (INITIAL): GOLD

to cont. Authorization to cont Expires 60 Mo from issue