IREDELL COUNTY HEALTH DEPARTMENT

STATESVILLE 704-878-5305 MOORESVILLE 704-664-5281

IMPROVEMENT PERMIT / AUTHORIZATION TO CONSTRUCT / OPERATION PERMIT / EXISTING SYSTEM INSPECTION

PERMIT# Repair PIN# -2585 DATE 9/4/02

OWNER OR CONTRACTOR Lena Milstead PHONE Business (704 — 872-6025 Don Milstead) Home (704) 873-7946

ADDRESS 3595 Taylorsville Hwy, Statesville N.C. 28677

LOCATION Hwy 90 West, White Frame House on Left just before Methodist Baptist Church

SUBDIVISION — BLOCK / SECTION — LOT — LOT AREA — SITE CLASS — DESIGN FLOW 250 L.T.A.R. —

Septic Tank: Existing Gallons: STB Date

Pump Tank: Gallons: PT Date

Pump Make: Model Serial No.

Nitrification Field: No Fields 1 Square Feet 720 Linear Feet 160'

No. Lines 4@40 Trench Width 36" Max Trench Bottom Depth [redacted] Gravel Depth 18"

☐ New System ☒ Repair System Type: I (II) III IV V VI

System Description: Gravity

Repair System Description: Gravity, Conv.

Maintenance Agreement Required: ☐ Yes ☒ No

☒ House/Mod. Home ☐ Mobile Home ☐ Business ☐ Other

No. Bedrooms 2 No. Bathrooms 1 No. Employees — Partial


☐ Slab ☐ Crawl Space ☐ Basement w/plumbing ☒ Basement wo/plumbing

Water Supply: ☒ Individual ☐ Public ☐ Community

Comments/Conditions: ① Install 4 lines with 18" Gravel on Contour ② use 4 drop boxes

Not to scale

INITIAL SITE SKETCH

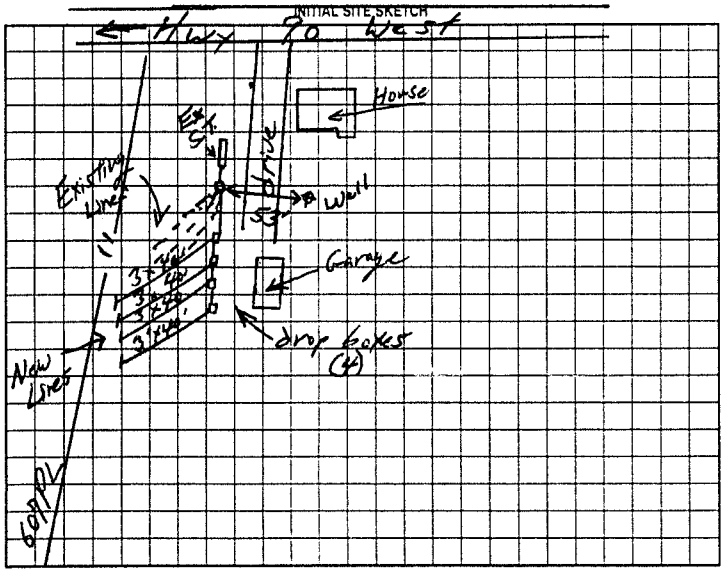

Comments/Conditions:

- Installed New Tee in [redacted] Septic tank.
- Removed old distribution box.
- Line length 43, 43, 43, and 40 ft with 20" of gravel.

AS BUILT SKETCH

169 Linear feet - total 20" of gravel.
Sq ft = 1/2 or greater than 250.

Installed as shown per Initial Site Sketch

Permit can be suspended or revoked if any false information is supplied toward securing the permit/any unauthorized changes are made to the site any unauthorized changes are made in the installation of the system. Improvement Permit with plat valid without expiration. Improvement Permit with site plan valid for sixty months. Authorization to Construct is valid for a period equal to that of Improvement Permit – not to exceed sixty months

Signed: Donald Milstead date 9/4/02 Installed by: Wes Yatton

Improvement Permit by: William O. Johnson date 9/4/02 Operation Permit by: William O. Johnson date 9/6/02

Authorization to Construct by: William O. Johnson date 9/4/02 Existing System Inspection by: — date —

HEALTH DEPT. COPY: WHITE OWNER COPY (FINAL): YELLOW OWNER COPY (INITIAL): PINK