IREDELL COUNTY HEALTH DEPARTMENT

STATESVILLE 704-878-5305 MOORESVILLE 704-664-5281

IMPROVEMENT PERMIT / AUTHORIZATION TO CONSTRUCT / OPERATION PERMIT / EXISTING SYSTEM INSPECTION

PERMIT# 72291 PIN# 4726316491

OWNER OR CONTRACTOR Eclipse Packaging DATE 3-27-98

ADDRESS 218 Saint Andrews Rd Sta. PHONE: Business 5394608 Home

LOCATION Hwy 90 W across from Monticello Bapt. Ch.

SUBDIVISION BLOCK / SECTION LOT LOT AREA 5 acres + SITE CLASS. PS DESIGN FLOW 1000 L.T.A.R. 1.3

Septic Tank: 2000 Gallons; STB 647 Date 2-17-98

Pump Tank: 2000 Gallons; PT 97 Date 10-3-97

Pump Make: Model Serial No.

Nitrification Field: No Fields 1 Square Feet 3360 Linear Feet 1120

No Lines 8 Trench Width 36" Max Trench Bottom Depth 36" Gravel Depth 12"

☑ New System ☐ Repair System Type: I, II, III, IV, V, VI

System Description: Pump to conv. lines

Repair System Description: " " " "

Maintenance Agreement Required: ☐ Yes ☑ No

☐ House/Mod. Home No. Bedrooms

☐ Mobile Home No. Bathrooms

☑ Business No. Employees 40

☐ Other

☑ Slab ☐ Crawl Space ☐ Basement w/plumbing ☐ Basement wo/plumbing

Water Supply: ☑ Individual ☐ Public ☐ Community


Comments:/Conditions:

Drive


Comments:/Conditions:

Masja Products Property (PL) 1000' +

INITIAL SITE SKETCH

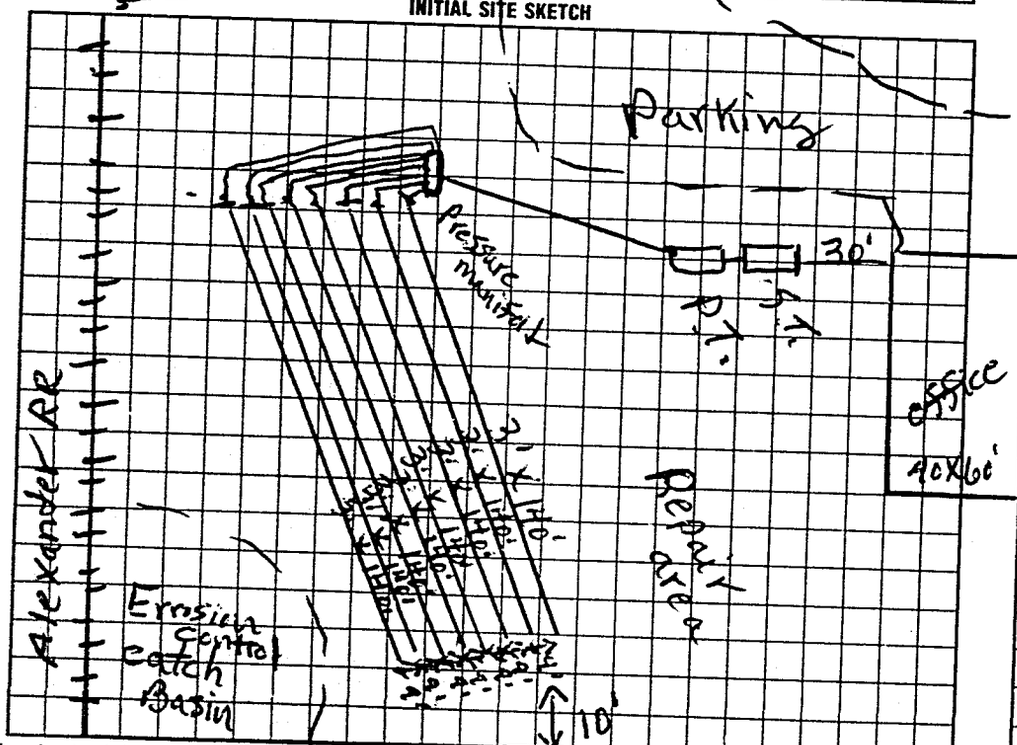

AS BUILT SKETCH

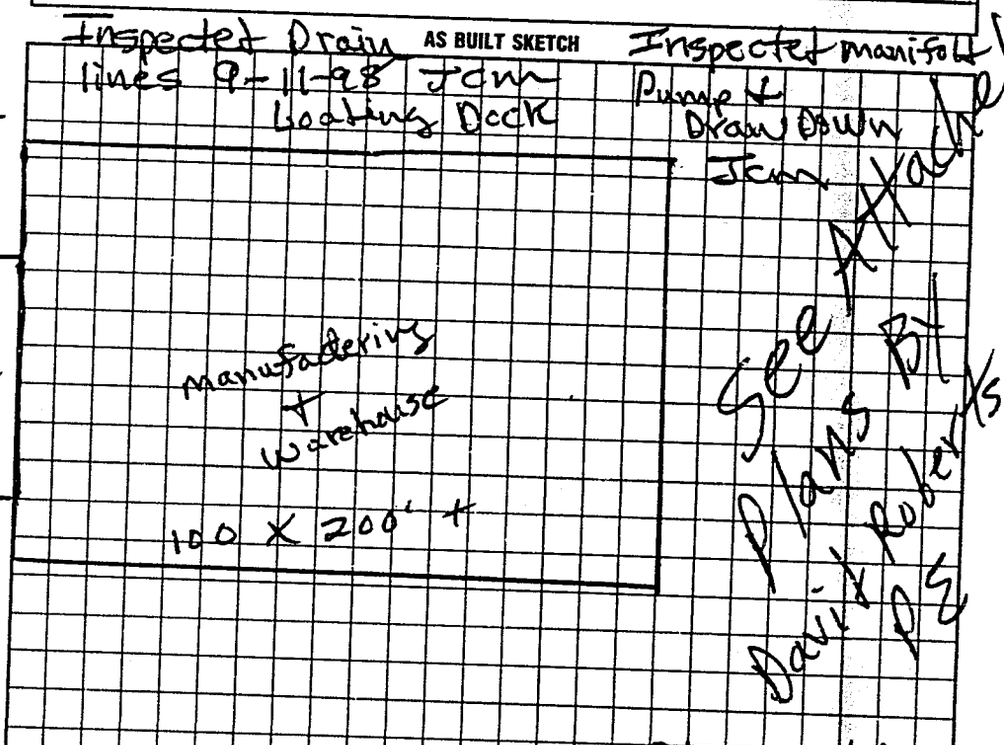

I understand that this permit can be suspended or revoked if any false information is supplied toward securing the permit/any unauthorized changes are made to the site/any unauthorized changes are made in the installation of the system. Improvement Permit with plat valid without expiration. Improvement Permit with site plan valid for sixty months. Authorization to Construct is valid for a period equal to that of Improvement Permit – not to exceed sixty months.

Signed: date 4-6-98

Improvement Permit by: P. C. Moore date 3-27-98

Authorization to Construct by: P. C. Moore date 3-27-98

Installed by: Kenny Mafison

Operation Permit by: P. C. Moore date 9-24-98

Existing System Inspection by: date

HEALTH DEPT. COPY: WHITE INSPECTION COPY (FINAL) GREEN OWNER COPY (FINAL) YELLOW INSPECTION COPY (INITIAL) PINK OWNER COPY (INITIAL) GOLD