IREDELL COUNTY HEALTH DEPARTMENT

Statesville Office (704) 878-5305 Mooresville Office (704) 660-3625 PERMIT # 20961

IMPROVEMENT PERMIT / AUTHORIZATION TO CONSTRUCT / OPERATION PERMIT / EXISTING SYSTEM

PIN # 4725207314

APPLICANT: Main Street Homes APPLICANT ADDRESS: 2908 Gastonia Dr.

SITE ADDRESS: 346 Island Ford Rd. PHONE: 704-818-6111 ALT. PHONE: N/A

SITE DIRECTIONS: Hwy 64 W TL Island Ford Property on Right

SUBDIVISION: N/A SECTION: N/A LOT # N/A LOT AREA: 33.33 acres DESIGN FLOW: Existing L.T.A.R.: Existing

Septic Tank Existing (gal) STB Date

Pump Tank (gal) PT Date

Pump Make Model Serial #

Nitrification Fields Ex # Lines Ex Linear Ft: Ex

Trench Width Ex Max. Trench Bottom Depth Ex Gravel Depth Ex

☐ New System ☐ Repair ☐ Expansion System Type: I (II) III IV V VI

System Description: Conventional Bed

Repair System Description:

Maintenance Agreement Required: ☐ YES ☑ NO

☐ GRAVITY ☐ PRESSURE

☑ Residence No. Bedrooms Ex

☐ Business No. Persons Ex

☐ Other No. Employees

☐ Slab ☐ Crawl Space

☐ Basement w/plumbing ☑ Basement w/o plumbing

Water Supply: ☑ Private ☐ Public ☐ Community

Comments / Conditions:


- Maintain a minimum of 5' between addition foundation & all components of septic tank system

INITIAL SITE SKETCH

Scale 1" = 60'

N

AS BUILT SKETCH

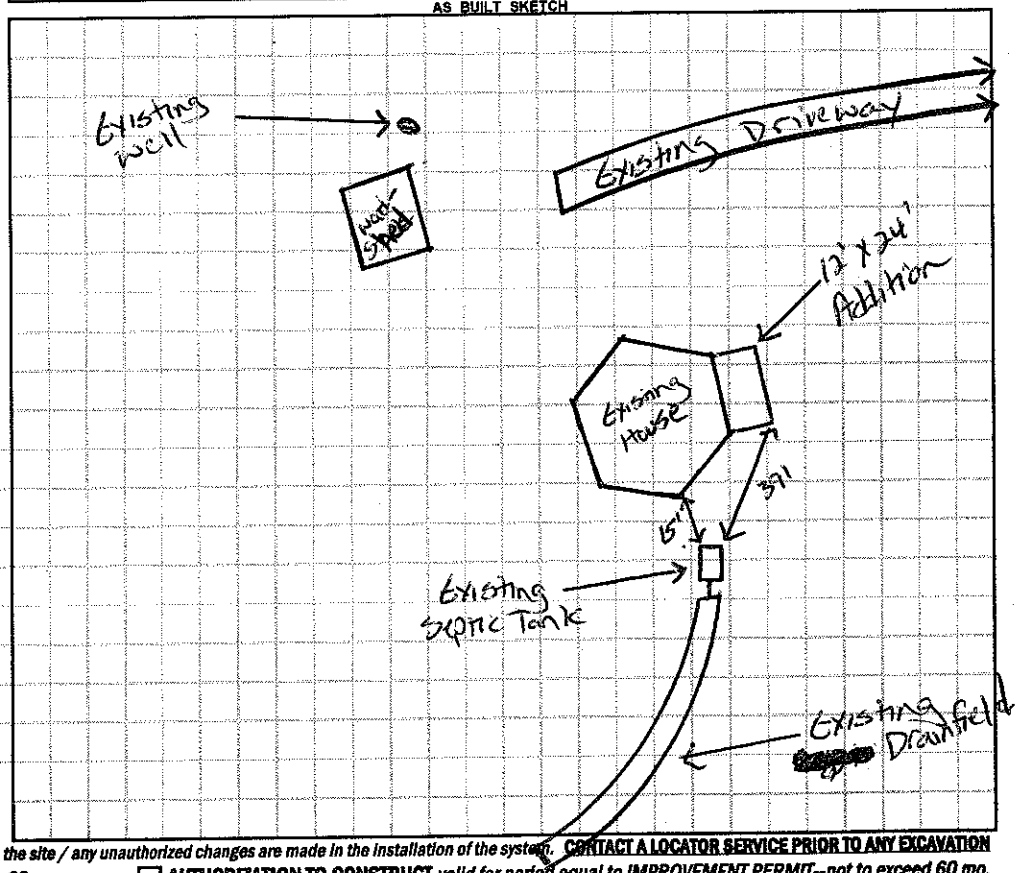

Permit can be suspended or revoked if any false information is supplied toward securing the permit / any unauthorized changes are made to the site / any unauthorized changes are made in the installation of the system. **CONTACT A LOCATOR SERVICE PRIOR TO ANY EXCAVATION**

☐ **IMPROVEMENT PERMIT** *with plat valid without expiration.* ☐ **IMPROVEMENT PERMIT** *with site plan valid for 60 mos.* ☐ **AUTHORIZATION TO CONSTRUCT** *valid for period equal to IMPROVEMENT PERMIT--not to exceed 60 mo.*

Owner / Applicant Signature: [signature] Date: 6-4-15 Installed by:

IMPROVEMENT PERMIT by: Date: OPERATION PERMIT by: Date:

AUTHORIZATION TO CONSTRUCT by: Date: Existing System Inspected by: [signature] Date: 5-27-15

Health Dept. Copy - WHITE Applicant (Final Approval) - YELLOW Applicant (Conditional Approval) - PINK