Pin # 4925-23-1784

IREDELL COUNTY HEALTH DEPARTMENT

Statesville Phone TR 3-7271 Mooresville Phone No. 664-5281

PERMIT TO INSTALL SEPTIC TANK

Permit No. _____ Permit Date 8-1 1973

Owner Don Hatton Address Statesville N.C.

Installed By York Rusty Address Stony Point N.C.


Location of Property Hwy # 90 Above Montiello Go. T.L. on Rd # 1656. Trailer on L. at end of road

Tank		Capacity		Length of Lines		Pictures	
Block	( )	1000	(✓)	225'	(✓)	No. of Baths	(1)
Precast	(✓)	1250	( )	250'	( )	Dishwasher	( )
		1500	( )	Other _____		Garbage Grdr.	( )
		Other _____				Other _____	

NOTIFY HEALTH DEPARTMENT AT LEAST EIGHT HOURS BEFORE TANK IS TO BE INSPECTED.

Final Inspection 8-1 1973 Approved (✓) Disapproved ( )

Remarks Well 86' from Lines

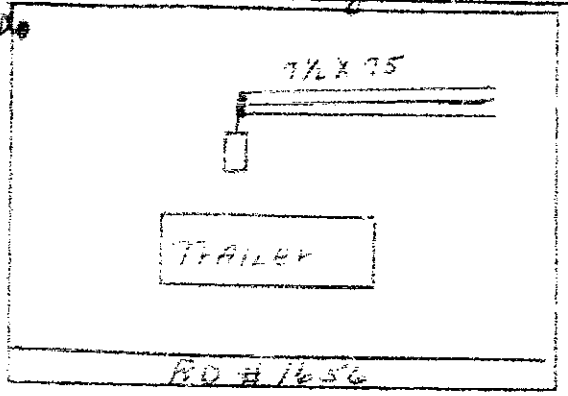

Sketch of Installation

E. G. Stevenson
Sanitarian

3 BR 150 220

1106 1 2 bdrm

2 bdrm 1 bath

MAY. 12, 19;5 19:52