IREDELL COUNTY HEALTH DEPARTMENT STATESVILLE 704-878-5305 MOORESVILLE 704-664-5281

IMPROVEMENT PERMIT / AUTHORIZATION TO CONSTRUCT / OPERATION PERMIT / EXISTING SYSTEM INSPECTION

PERMIT # REPAIR PIN # 4725-23-2555 DATE MAY 10, 2012

OWNER or APPLICANT HAL B. BEASLEY JR PHONE: Business 704-872-6052 Home: 704-880-6530

OWNER or APPLICANT ADDRESS 189 BUTTERFIELD CIRCLE, STATESVILLE

LOCATION / DIRECTIONS NC 90 W, TR BUTTERFIELD CIRCLE, HOUSE ON OUTSIDE of CIRCLE AT #189

SUBDIVISION WEST MONTICELLO, BLOCK / SECTION LOT # 21 & 22 LOT AREA 1.342 AC DESIGN FLOW 360 L.T.A.R. 0.40 GPD/FT2

Septic Tank EXISTING Gallons: STB Date

Pump Tank Gallons: P T Date

Pump Make Model Serial #

Nitrification Field No Fields 1 No Lines 2 Linear Feet 200

Trench Width 36" Max. Trench Bottom Depth 36" Gravel Depth N/A

☐ New System ☑ Repair ☐ Expansion System Type I II (III) IV V VI

System Description:

Repair System Description: 25% REDUCTION, GRAVITY

Maintenance Agreement Required ☐ YES ☑ NO

☑ GRAVITY ☐ PRESSURE

☑ Residence No. Bedrooms 3

☐ Business No. Persons

☐ Other No. Employees

☐ Slab ☐ Crawl Space


☑ Basement w/plumbing ☐ Basement w/o plumbing

Water Supply ☑ Private WELLS (2) ☐ Public ☐ Community

Comments / Conditions INSTALL 25% REDUCTION SYSTEM ON CONTOUR AS FLAGGED USING SERIAL DISTRIBUTION. KEEP SYSTEM MIN. 50' FROM WELL

Comments / Conditions

INITIAL SITE SKETCH

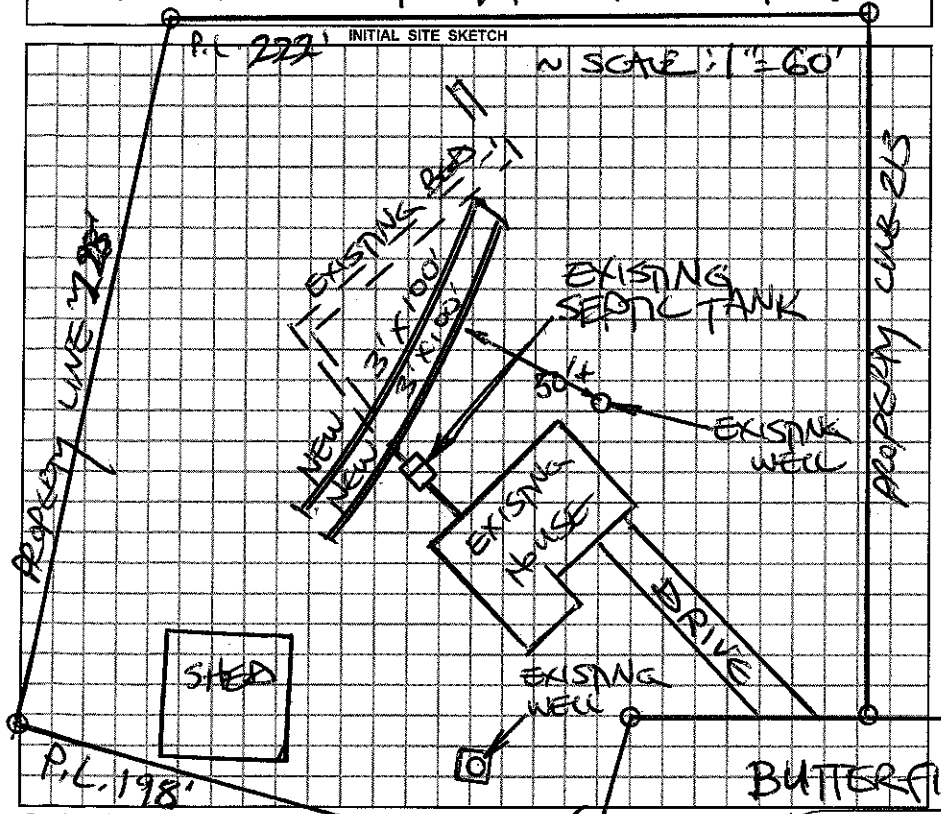

AS BUILT SKETCH

SYSTEM REPAIRED ACCORDING TO INITAL SITE SKETCH USING 50 QUICK-4 INFILTRATOR CHAMBERS

Permit can be suspended or revoked if any false information is supplied toward securing the permit / any unauthorized changes are made to the site / any unauthorized changes are made in the installation of the system.

☐ *IMPROVEMENT PERMIT w / plat valid without expiration* ☑ *IMPROVEMENT PERMIT w / site plan valid for 60 mos.* ☑ *AUTHORIZATION TO CONSTRUCT valid for period equal to IMPROVEMENT PERMIT-not to exceed 60 mo.*

Owner / Applicant Signature: Hal B Beasley Date 5-10-12 Installed by: A-1 BACKHOE

Improvement Permit by: STEVE HEDRICK Date 5-10-12 Operation Permit by: STEVE HEDRICK Date: 5/10/12

Authorzation to Construct by: STEVE HEDRICK Date 5-10-12 Existing System Inspected by: Date:

YOU SHOULD CONTACT A LOCATOR SERVICE PRIOR TO ANY EXCAVATION.

WHITE COPY Environmental Health YELLOW COPY (Final) Owner / Applicant PINK COPY (Initial) Owner / Applicant