IREDELL COUNTY HEALTH DEPARTMENT

Statesville Phone TR 3-7271 Mooresville Phone NO 3-1271

PERMIT TO INSTALL SEPTIC TANK

Permit Date 3-31 1962

Permit NO. _____

Owner GEORGE BOSTIC Address _____

Installed By CARL SEITZ PLANT CO Address CATAWBA

Location of Property HWY 90 WEST PASS MONTICELLO DRIVE


1st GATED ROAD LEFT 3rd IF 3 WHITE FRAME ON LEFT

Tank	Capacity		Length of Lines		Fixtures	
Block ( )	800	( )	150'	( )	No. of Baths	(1)
Precast (✓)	900	( )	175'	( )	Dishwasher	( )
ROWAN	1000	(✓)	200'	( )	Garbage Grdr.	( )
	1100	( )	225'	(✓)	Auto-Washer	( )
	1200	( )	250'	( )	Other	_____
	Other	_____	Other	_____		

NOTIFY HEALTH DEPARTMENT AT LEAST EIGHT HOURS BEFORE TANK IS TO BE INSPECTED.

Final Inspection 3-30 196- Approved (✓) Disapproved ( )

Remarks _____

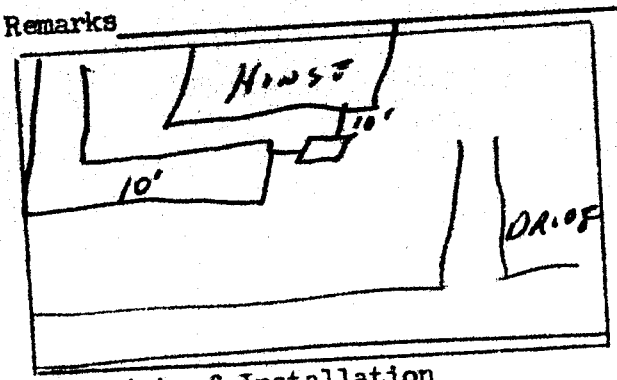

Sketch of Installation

Raphael G. Thomas

Sanitarian