IREDELL COUNTY HEALTH DEPARTMENT

Statesville Phone TR 3-7271 Mooresville Phone NO 3-1271

PERMIT TO INSTALL SEPTIC TANK

Permit NO._____ Permit Date 3-30 1962

Owner GEORGE BUSTLE CONTR Address _____

Installed By CARL SETZER PLANT CO Address CATAWBA


Location of Property UP HWY 90 WEST PASS MONTICELLO DRIVE 1st PAVED ROAD LEFT 2nd OF 3 WHITE FRAME ON LEFT

Tank		Capacity		Length of Lines		Fixtures	
Block	(✓)	800	( )	150'	( )	No. of Baths	(1)
Precast	( )	900	( )	175'	( )	Dishwasher	( )
		1000	(✓)	200'	( )	Garbage Grdr.	( )
Rowan		1100	( )	225'	(✓)	Auto-Washer	( )
		1200	( )	250'	( )	Other	_____
		Other	_____	Other	_____		

NOTIFY HEALTH DEPARTMENT AT LEAST EIGHT HOURS BEFORE TANK IS TO BE INSPECTED.

Final Inspection WELL 3-30 1962 Approved (✓) Disapproved ( )

Remarks _____

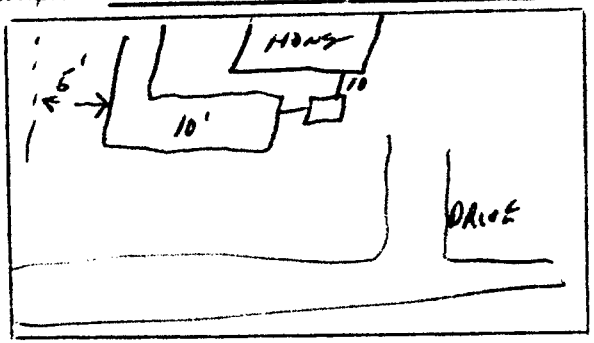

Sketch of Installation

Raymond G Thomas

Sanitarian