IREDELL COUNTY HEALTH DEPARTMENT

STATESVILLE 704-878-5305 MOORESVILLE 704-664-5281

IMPROVEMENT PERMIT / CERTIFICATE OF COMPLETION / OPERATION PERMIT / EXISTING SYSTEM INSPECTION

PROPERTY DESCRIPTION NO. 23678 DATE 5-15-96 TAX MAP NO. 8J-A-17A Watershed: ☐ Yes ☐ No

OWNER OR CONTRACTOR Bob Travis PHONE: Business Home 872 9806

ADDRESS PO Box 5451 Sta

LOCATION 70W Part old mtn Rd To Shady Nest TR Gypsy 300' Rt

SUBDIVISION Travis Mt HP BLOCK / SECTION LOT 5 LOT AREA SITE CLASS DESIGN FLOW L.T.A.R. SCMA

Septic Tank: 1000 Gallons; STB Date

Pump Tank: Gallons; PT Date

Pump Make: Model Serial No.

Nitrification Field: No Fields 1 Square Feet 1750 Linear Feet 250

No Lines 2 Trench Width 36 Max Trench Bottom Depth 36

☐ New System ☐ Repair System Type: I. II. III. IV. V. VI

System Description:

Repair System Description:

Maintenance Agreement Required: ☐ Yes ☐ No

Gravel Depth 12" ☐ Slab ☒ Crawl Space ☐ Basement w/plumbing ☐ Basement wo/plumbing

☐ House/Mod. Home No. Bedrooms 3

☐ Mobile Home No. Bathrooms 2

☐ Business No. Employees

☐ Other


Water Supply: ☐ Individual ☐ Community ☒ Public

Comments:

Comments:

INITIAL SITE SKETCH

AS BUILT SKETCH

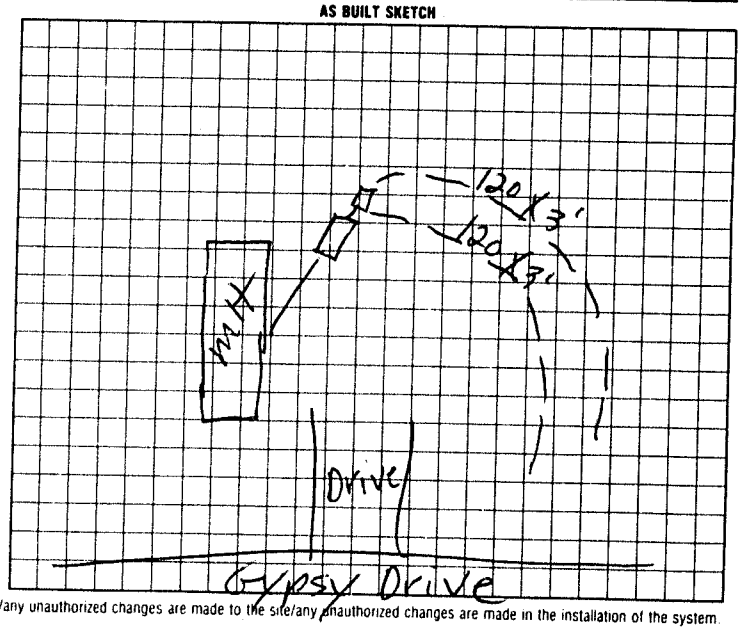

I understand that this permit can be suspended or revoked if any false information is supplied toward securing the permit/any unauthorized changes are made to the site/any unauthorized changes are made in the installation of the system.

Signed:

Improvement Permit by: date

Existing System Inspection by: P. C. Moore date 5-15-96

Installed by: Wes Fytton

Certificate of Completion by: Steve Brown date 5-7-82

Operation Permit by: date

HEALTH DEPT. COPY: WHITE INSPECTION COPY (FINAL) GREEN OWNER COPY (FINAL) YELLOW INSPECTION COPY (INITIAL) PINK OWNER COPY (INITIAL) GOLD