ICHD - ENVIRONMENTAL HEALTH DIVISION

Statesville Office (704) 878-5305 x3456 | Mooresville Office (704) 660-3625

SEPTIC: IMPROVEMENT PERMIT / AUTHORIZATION TO CONSTRUCT / OPERATION PERMIT / EXISTING SYSTEM

SH

PERMIT: OSWP 2024 58263

PIN # 4725-25-3040

APPLICANT/OWNER: MICHAEL MUNDWILER | APPLICANT ADDRESS: 111 ABSHER FARM LOOP STATESVILLE NC 28625

SITE ADDRESS: 111 ABSHER FARM LOOP STATESVILLE NC 28625 | PHONE: 704-402-8016 | ALT. PHONE

SITE DIRECTIONS: HWY 90 → (L) ABSHER FARM LOOP → 1st Home on (L) | SAP CONTROLLED: ☐ YES ☐ NO

SUBDIVISION: — | SECTION: — | LOT #: — | LOT AREA: 1.23 | DESIGN FLOW: 360 | L.T.A.R.(Initial): — | L.T.A.R (Repair): —


Septic Tank 1000 (gal)	STB 760	Date	☐ New System	☒ Repair	☐ Expansion	System Type: I (II) III IV V VI	☒ Residence	No. Bedrooms 3	Water Supply
Pump Tank (gal)	PT	Date	System Description: —				☐ Business	No. Persons 6	☒ Private
Pump Make	Model	Serial #	Repair System Description: TANK REPLACEMENT				☐ Other	No. Employees —	☐ Public
# Nitrification Fields 1	# Lines 3	Linear Ft EXT 210'	Maintenance Agreement Required:	☐ YES	☒ NO		☐ Slab	☒ Crawl Space	☐ Community
Trench Width	*Max. Trench Depth(Initial) —	*Max. Trench Depth(Repair) —	Gravel Depth —	☒ GRAVITY	☐ PRESSURE		☐ Basement w/plumbing	☐ Basement w/o plumbing	

* Measured on the downhill side of the trench | Effluent Standard: ☒ DSE ☐ HSE ☐ TS-I ☐ TS-II ☐ RCW ☐ NSF/ANSI 40 | Usable Depth to LC (Initial): — | Usable Depth to LC (Repair): — | *Limiting Condition*

Comments / Conditions: Pump, crush, fill existing tank. Replace tank in same location if needed. Replace distribution as needed. See attached permit from 2003.

Recommend removing above ground pool + deck.

INITIAL SITE SKETCH

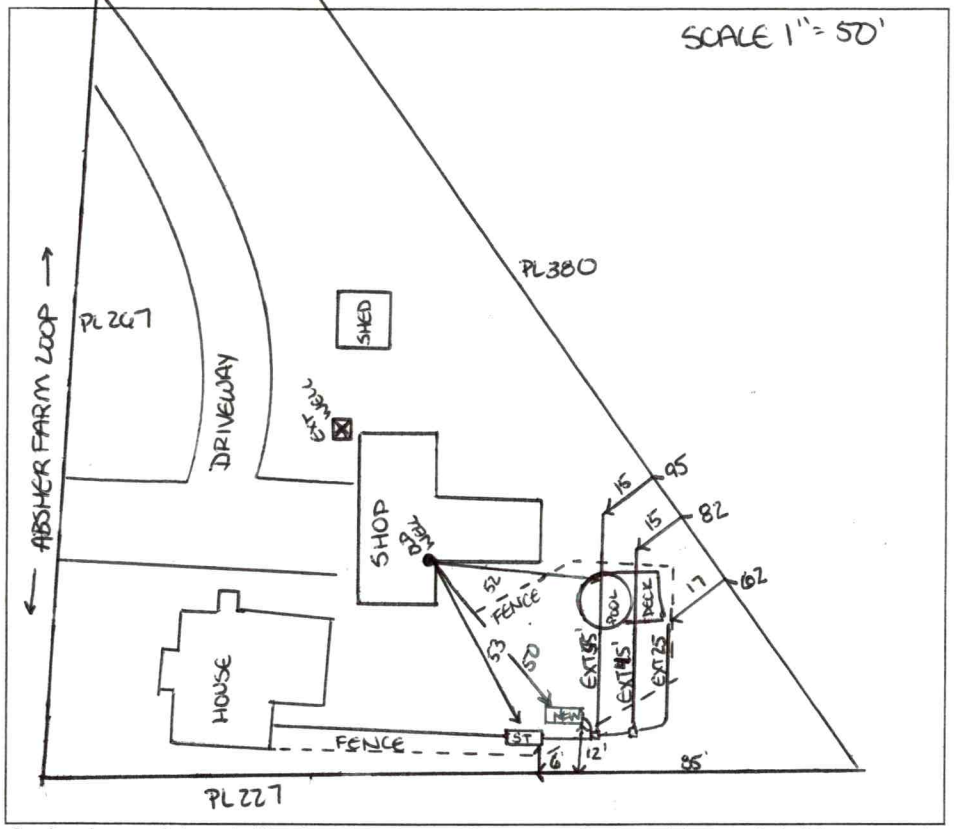

AS BUILT SKETCH

FOR SEPTIC FINAL INSPECTION CALL: 704-664-3703 between 8am-9am
the day the inspection is needed. Be sure to speak with an inspector to confirm your time.

Installed as drawn. Leak in plumbing found at install. Owner informed of leak and that if leak is not corrected that it may require future repair due to oversaturated drainlines.

Permit can be suspended or revoked if any false information is supplied toward securing the permit / any unauthorized changes are made to the site / any unauthorized changes are made in the installation of the system. **CONTACT A LOCATOR SERVICE PRIOR TO ANY EXCAVATION**

☐ **IMPROVEMENT PERMIT** *with plat* valid without expiration. ☒ **IMPROVEMENT PERMIT** *with site plan* valid for 60 mos. ☒ **AUTHORIZATION TO CONSTRUCT** valid for period equal to IMPROVEMENT PERMIT--not to exceed 60 mo.

Owner / Applicant Signature: ONLINE | Date: — | Installed by: Lentz

IMPROVEMENT PERMIT by: Sarah Williams | Date: 8/14/2024 | OPERATION PERMIT by: Sarah Williams | Date: 8/26/24

AUTHORIZATION TO CONSTRUCT by: Sarah Williams | Date: 8/14/2024 | Existing System Inspected by: | Date:

Item	Date	Initials
Drain Lines Checked		
Tanks Checked		
Pressure Manifold or Valve Box Checked		
Pressure Head Set		
Electrical Checked		
Floats Set		
Alarm Checked		
Maintenance Contract Needed? Y / N		
Comments:		

Repairs Only	
	State Code
Failing System Code	
Type of Distribution	G or P
Type of Failure/Malfunction	
Primary Cause of Failure/Malfunction	
Age of System? _____	
Initial or Repair? _____	

PERMIT SNAPSHOT REPORT OSWP-2024-58263 FOR IREDELL COUNTY

Permit Type	Environmental Health OSWP	**Project:**		**App Date:**	07/24/2024
Work Class:	EH Septic Permit	**District:**	Iredell County	**Exp Date:**	NOT AVAILABLE
Status:	PRIORITY PERMIT	**Square Feet:**	0.00	**Completed:**	NOT COMPLETED
Valuation:	$0.00	**Assigned To:**	Bracken, Sarah	**Approval Expire Date:**	
Description:	replace tank, caving in				

Parcel: 4725253040.000 Main	**Address:** 111 Absher Farm Loop Statesville, NC 28625 Main	**Zone:** RA(Residential Agricultural District)

Property Owner	Applicant/Authorized Agent
MICHAEL F+PEGGY L MUNDWILER	michael mundwiler 111 absher farm loop statesville, NC 28625

Permit Custom Fields

How is your site plan being submitted	Custom Site Plan	Septic Application/Permit Type	Repair	Does the site contain any jurisdictional wetlands	No
Non-domestic Sewage Generated	No	Other Public Agency	No	All proposed structure dimensions	na
Maximum Number of Bedrooms	3	If other Addition/Structure, please explain		Number of Occupants	6
Foundation Type	Basement without Plumbing	Water Supply	Existing Well	Desired Septic System Type	Conventional (most common)
If other septic system type, please explain		Pump Make		# of Nitrification Fields	
Model		Serial #		System Description	
Repair System Description		Comments/Conditions		Additional Unique Setbacks Apply	No

Attachment File Name	Added On	Added By	Attachment Group	Notes
Signature_michael_mundwiler_7/24/2024.jpg	07/24/2024 9:52	mundwiler, michael		Uploaded via CSS
aa111_v1.pdf	07/24/2024 12:15	mundwiler, michael	Available Online	
site plan 111_v1.pdf	07/24/2024 12:15	mundwiler, michael	Available Online	

Workflow Step / Action Name	Action Type	Start Date	End Date
Application Completeness Check v.1		07/24/2024 12:15	07/24/2024 12:15
Confirm application complete v.1	Generic Action		07/24/2024 12:15
Lot Readiness Verification v.1			
~~OSWP Septic Preliminary Site Visit v.1~~	Inspection		07/24/2024 12:16
OSWP Site Evaluation v.1	Inspection		
~~**Zoning Review v.1**~~			07/24/2024 12:15
~~Floodplain Admin Overview v.1~~	Task		07/24/2024 12:15
~~Issue Invoice v.1~~	Generic Action		07/24/2024 12:15
~~Fees Paid v.1~~	Generic Action		07/24/2024 12:15
Fees v.1			
Issue Invoice v.1	Generic Action		
Fees Paid v.1	Generic Action		
Issue Improvement Permit v.1			
Issue Invoice v.1	Generic Action		

PERMIT SNAPSHOT REPORT (OSWP-2024-58263)

Fees Paid v.1	Generic Action
Issue Permit v.1	Generic Action
Permit Completion Process v.1	
Authorization to Construct Permit v.1	Create Sub Permit
Issue Authorization to Construct v.1	Generic Action

IREDELL COUNTY HEALTH DEPARTMENT

STATESVILLE 704-878-5305 MOORESVILLE 704-664-5281

IMPROVEMENT PERMIT / AUTHORIZATION TO CONSTRUCT / OPERATION PERMIT / EXISTING SYSTEM INSPECTION

PERMIT# Repair PIN# 4725-25-~~2081~~ 3040 DATE 6/23/03

OWNER OR CONTRACTOR Mike Munsiler PHONE: Business — Home (704) 924-6930

ADDRESS 111 Absher Farm Rd Statesville NC. 28625

LOCATION I-40 W, ~~(40)~~ (5) on Hwy 90, (6) Absher Farm Loop 1st House on Left (111 Absher Farm Loop)

SUBDIVISION — BLOCK / SECTION — LOT — LOT AREA — SITE CLASS. 5 DESIGN FLOW 360 L.T.A.R. .30

Septic Tank: Exist Gallons; STB — Date —
Pump Tank: — Gallons; PT — Date —
Pump Make: — Model — Serial No. —
Nitrification Field: No Fields 1 Square Feet — Linear Feet 240
No Lines 3 Trench Width 36" Max Trench Bottom Depth — Gravel Depth 24"

☐ New System ☒ Repair System Type: I, II, III, IV, V, VI
System Description: —
Repair System Description: Gravity, Conventional
Maintenance Agreement Required: ☐ Yes ☒ No


☒ House/Mod. Home No. Bedrooms 3
☐ Mobile Home No. Bathrooms 1
☐ Business No. Employees —
☐ Other —
☐ Slab ☐ Crawl Space ☐ Basement w/plumbing ☒ Basement wo/plumbing

Water Supply: ☒ Individual ☐ Public ☐ Community


Comments/Conditions: (1) Add three Lines 55, 40, 25 ft w/ 24" Gravel (2) Pump out S.T. (3) Remove maple trees (2) (3) dam up old Line. Stub from PL + disconnect 2nd existing Line. This permit serves as N.O.V.

Comments/Conditions: - disconnected old line. Ex. 30 days to repair system.

INITIAL SITE SKETCH

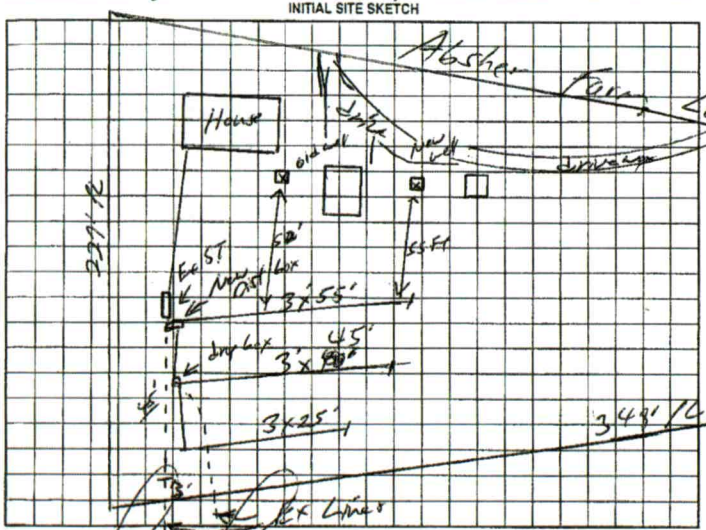

AS BUILT SKETCH

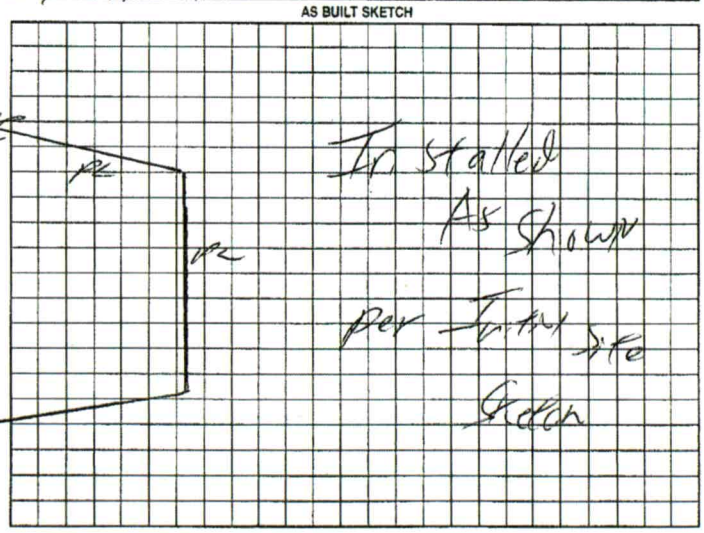

Permit can be suspended or revoked if any false information is supplied toward securing the permit/any unauthorized changes are made to the site/any unauthorized changes are made in the installation of the system. Improvement Permit with plat valid without expiration. Improvement Permit with site plan valid for sixty months. Authorization to Construct is valid for a period equal to that of Improvement Permit – not to exceed sixty months.

Signed: [signature] date 6/23/03 Installed by: Tommy Shoemaker

Improvement Permit by: William O. Roberson date 6/23/03 Operation Permit by: William R. Parker date 8/6/03