MW

ICHD - ENVIRONMENTAL HEALTH DIVISION

Statesville Office (704) 878-5305 Mooresville Office (704) 660-3625 PERMIT # 2023-25161

SEPTIC: IMPROVEMENT PERMIT / AUTHORIZATION TO CONSTRUCT / OPERATION PERMIT / EXISTING SYSTEM Repair PIN # 4725 -- 26 -- 6100

APPLICANT/OWNER: Jimmy Taylor APPLICANT ADDRESS: 134 Grayson Park Rd

SITE ADDRESS: 134 Grayson Park Rd, Statesville 28625 PHONE: 704-873-4196 ALT. PHONE —

SITE DIRECTIONS: Taylorsville Hwy - Grayson Park SAP CONTROLLED: ☐ YES ☒ NO


SUBDIVISION: — SECTION: — LOT # — LOT AREA: 5 acres DESIGN FLOW: 240 gpd L.T.A.R.: 0.3

Septic Tank	EX (gal)	STB	760	Date	9-30-23	☐ New System ☒ Repair ☐ Expansion System Type: I II (III) IV V VI	☒ Residence	No. Bedrooms	2
Pump Tank	(gal)	PT		Date		System Description:	☐ Business	No. Persons	4
Pump Make		Model		Serial #		Repair System Description: 25% reduction	☐ Other	No. Employees	
# Nitrification Fields	1	# Lines	2	Linear Ft:	200'	Maintenance Agreement Required: ☐ YES ☒ NO	☐ Slab	☒ Crawl Space	
Trench Width	36in	Trench Bottom Depth	Low side 32in	Gravel Depth	—	☒ GRAVITY ☐ PRESSURE	☐ Basement w/plumbing	☐ Basement w/o plumbing	

Water Supply: ☒ Private ☐ Public ☐ Community


Comments / Conditions: Install on contour with the land. Do not grade, park, or drive on septic area.

INITIAL SITE SKETCH

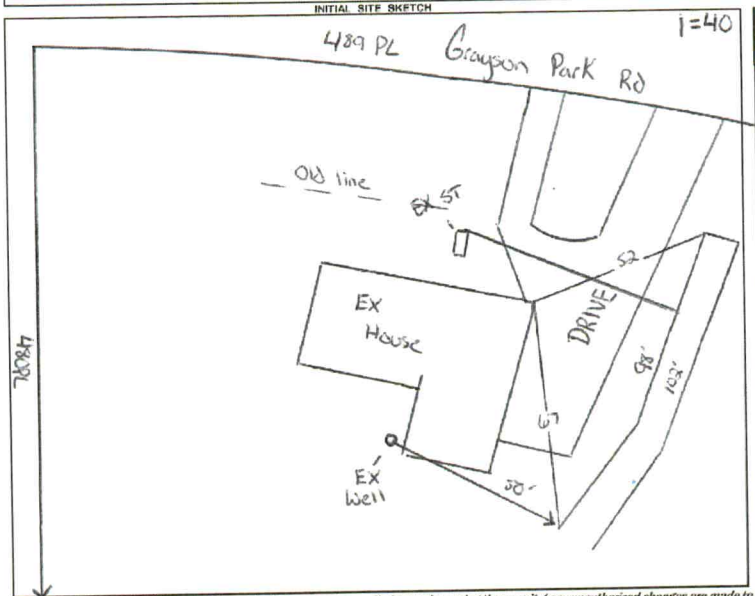

AS BUILT SKETCH

FOR SEPTIC FINAL INSPECTION CALL: 704-664-3703 between 8am-9am the day the inspection is needed. Be sure to speak with an inspector to confirm your time.

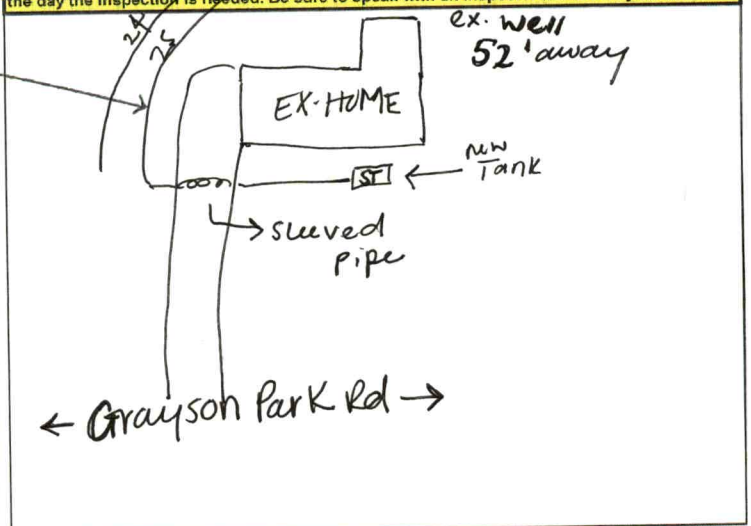

Permit can be suspended or revoked if any false information is supplied toward securing the permit / any unauthorized changes are made to the site / any unauthorized changes are made in the installation of the system. CONTACT A LOCATOR SERVICE PRIOR TO ANY EXCAVATION

☐ IMPROVEMENT PERMIT *with plat valid without expiration.* ☒ IMPROVEMENT PERMIT *with site plan valid for 60 mos.* ☒ AUTHORIZATION TO CONSTRUCT *valid for period equal to IMPROVEMENT PERMIT--not to exceed 60 mo.*

Owner / Applicant Signature: Online Signature Date: —

IMPROVEMENT PERMIT by: Cory Hill Date: 5/18/23

AUTHORIZATION TO CONSTRUCT by: Cory Hill Date: 5/18/23

Installed by: Lentz

OPERATION PERMIT by: Sydney Howard Date: 11/27/23

Existing System Inspected by: — Date: —

FOR SEPTIC FINAL INSPECTION: CALL 704-664-3703 between 8am-9am the day the inspection is needed.