IREDELL COUNTY HEALTH DEPARTMENT

STATESVILLE 704-878-5305 MOORESVILLE 704-664-5281

IMPROVEMENT PERMIT / CERTIFICATE OF COMPLETION / OPERATION PERMIT / EXISTING SYSTEM INSPECTION

PROPERTY DESCRIPTION NO. 22296 DATE _____ TAX MAP NO. 9D-4-A-14 Watershed: ☐ Yes ☒ No

OWNER OR CONTRACTOR MARIE L. WEST GOBLE PHONE: Business _____ Home 873-4716

ADDRESS 181 GRAYSON PARK ROAD STATESVILLE NC 28677

LOCATION NC 90 W TR GRAYSON PARK RD, BEAR (R) THEN (L), MH ON (L) BESIDE EXISTING BRICK (H)


SUBDIVISION MONTECELLO HEIGHTS BLOCK / SECTION _____ LOT 14 LOT AREA 200 x 260 SITE CLASS PS DESIGN FLOW 360 L.T.A.R. EXISTING

Septic Tank: EXISTING Gallons; STB _____ Date _____	☐ New System ☐ Repair System Type: I, (II), III, IV, V, VI	☐ House/Mod. Home No. Bedrooms 3	Water Supply:
Pump Tank: _____ Gallons; PT _____ Date _____	System Description: CONV. GRAVITY	☒ Mobile Home No. Bathrooms 2	☐ Individual
Pump Make: _____ Model _____ Serial No. _____	Repair System Description: _____	☐ Business No. Employees _____	☐ Community
Nitrification Field: No Fields 1 Square Feet _____ Linear Feet EXISTING	Maintenance Agreement Required: ☐ Yes ☒ No	☐ Other _____	☒ Public
No Lines EXISTING Trench Width _____ Max Trench Bottom Depth _____	Gravel Depth _____	☐ Slab ☐ Crawl Space ☐ Basement w/plumbing ☐ Basement wo/plumbing	


Comments:

Comments: KEEP MH MINIMUM 5' FROM SYSTEM

INITIAL SITE SKETCH

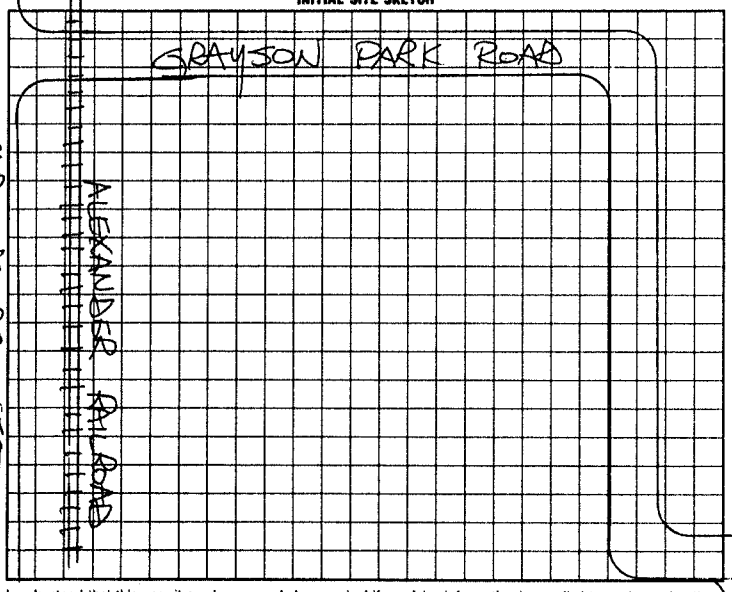

AS BUILT SKETCH

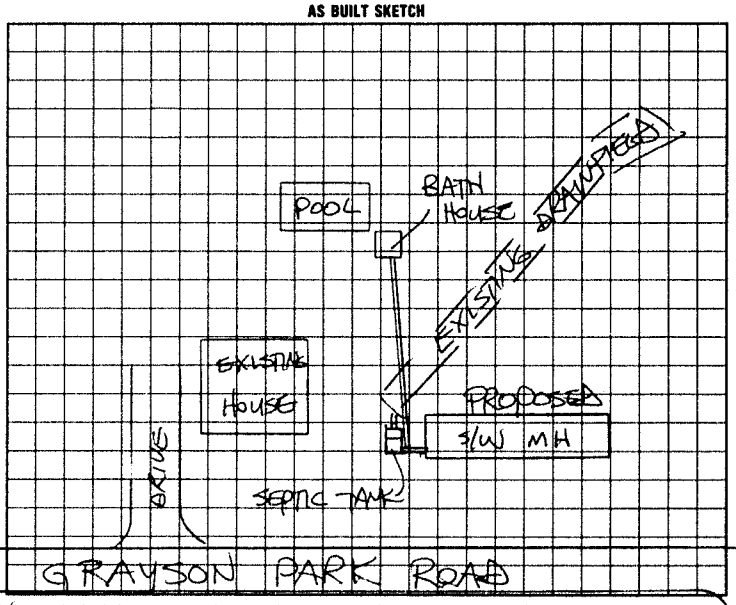

I understand that this permit can be suspended or revoked if any false information is supplied toward securing the permit/any unauthorized changes are made to the site/any unauthorized changes are made in the installation of the system. Improvement Permit is valid for 60 months from date of issuance.

Signed: _____

Improvement Permit by: _____ date _____

Existing System Inspection by: STEVE HEDRICK date 10/18/95

Installed by: _____

Certificate of Completion by: _____ date _____

Operation Permit by: _____ date _____

HEALTH DEPT. COPY: WHITE INSPECTION COPY (FINAL): GREEN OWNER COPY (FINAL): YELLOW INSPECTION COPY (INITIAL): PINK OWNER COPY (INITIAL): GOLD