IREDELL COUNTY HEALTH DEPARTMENT

Statesville Phone TR 3-7271 Mooresville Phone No. 664-5281

PERMIT TO INSTALL SEPTIC TANK

Permit No. 46 Permit Date 11-2 1972

Owner M & J Sales Address Statesville NC

Installed By Harlee Lackey Address Stony Point NC

Location of Property out Hwy 90 - T.R. at Kens Grc on Rd #1545. Go to trailer Park. 1st on L.


Grayson Park

Tank		Capacity		Length of Lines		Fixtures	
Block	( )	1000	(✓)	225'	(✓)	No. of Baths	(1)
Precast	(✓)	1250	( )	250'	( )	Dishwasher	( )
		1500	( )	Other		Garbage Grdr.	( )
		Other				Other	

NOTIFY HEALTH DEPARTMENT AT LEAST EIGHT HOURS BEFORE TANK IS TO BE INSPECTED.

Final Inspection 11-2 1972 Approved (✓) Disapprcved ( )

Remarks Community Water

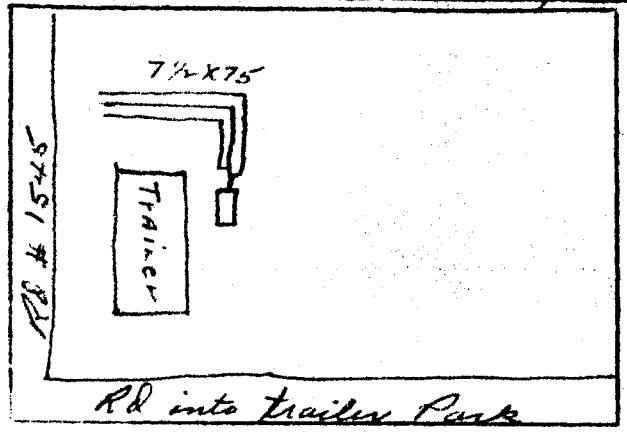

Sketch of Installation

Lot #11

E. G. Stevenson

Sanitarian