IREDELL COUNTY HEALTH DEPARTMENT

Statesville Phone TR 3-7271 Mooresville Phone No. 664-5281

PERMIT TO INSTALL SEPTIC TANK

Permit No. 103 Permit Date 12 - 8 1972

Owner M & F. Sales Address Statesville N.C.

Installed By Harley Lackey Address Stony Point NC


Location of Property Hwy # 90 Past Monticello School T.R. at Kens Gro on Rd # 1546 Grayson Park. 2nd on L.

Tank		Capacity		Length of Lines		Fixtures	
Block	( )	1000	(✓)	225'	(✓)	No. of Baths	( )
Precast	(✓)	1250	( )	250'	( )	Dishwasher	( )
		1500	( )	Other		Garbage Grdr.	( )
		Other				Other	

NOTIFY HEALTH DEPARTMENT AT LEAST EIGHT HOURS BEFORE TANK IS TO BE INSPECTED.

Final Inspection 12-8 1972 Approved (✓) Disapproved ( )

Remarks Community Water

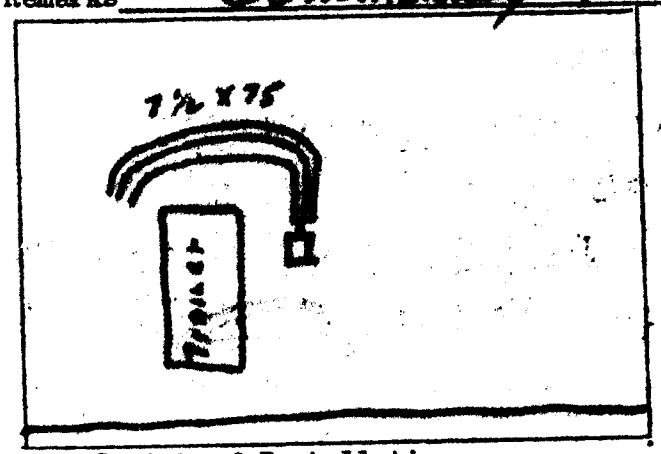

Sketch of Installation

This installation for 1 Trailer Lot # 12

E. G. Stevenson

Sanitarian