IREDELL COUNTY HEALTH DEPART

Statesville Phone TR 3-7271 Mooresville Phone NO 3-12

PERMIT TO INSTALL SEPTIC TANK

Permit NO. 208 Permit Date JUNE 18 197

Owner MELVIN BOWES Address RT.8 - STATESVILLE, NC

Installed By H.L. HEDRICK Address RT. 8 STATESVILLE NC


Location of Property HIGHWAY 90 WEST, TURN LEFT ON ROAD # 1615 2ND HOUSE ON RT. BACK OF TREATMAN UPH. SHOP.

Tank		Capacity		Length of Lines		Fixtures	
Block	( )	1000	(✓)	225'	(✓)	No. of Baths	(1)
Precast	(✓)	1250	( )	250'	( )	Dishwasher	( )
		1500	( )	Other		Garbage Grdr.	( )
		Other				Other	

NOTIFY HEALTH DEPARTMENT AT LEAST EIGHT HOURS BEFORE TANK IS TO BE INSPECTED.

Final Inspection JUNE 18 1976 Approved (✓) Disapproved ( )

Remarks

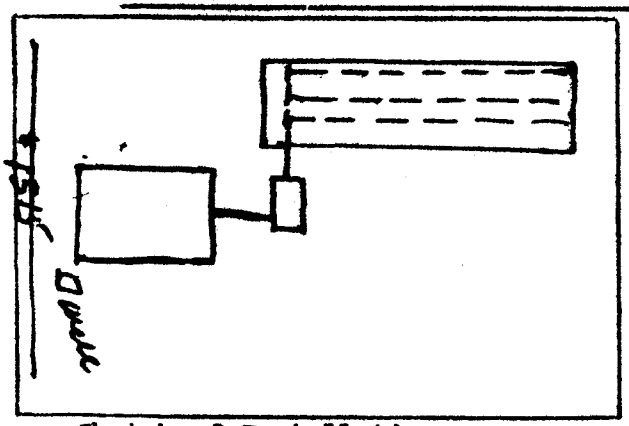

Sketch of Installation

Glenn Todd

Sanitarian