IREDELL COUNTY HEALTH DEPARTMENT - *ENVIRONMENTAL HEALTH* ☒ STATESVILLE OFFICE 704-878-5305 ☐ MOORESVILLE OFFICE 704-664-5281

IMPROVEMENT PERMIT / AUTHORIZATION TO CONSTRUCT / OPERATION PERMIT / EXISTING SYSTEM INSPECTION

PERMIT # 173521 PIN # 4725325989 DATE 7-18-12

OWNER Teresa Y Moose APPLICANT: PHONE: Home/Cell # 704 902 8830 Business #

SITE ADDRESS 126 Weaver Hill Dr. OWNER / APPLICANT ADDRESS

SITE DIRECTIONS 40W, take Hwy 90 exit, (R) on Hwy 90, (L) on Weaver Hill, 126 on (R)

SUBDIVISION G Earl Weaver BLOCK / SECTION n/a LOT # 2 LOT AREA .4 DESIGN FLOW 240 L.T.A.R. .3

Septic Tank existing Gallons: STB Date

Pump Tank Gallons: P T Date

Pump Make Model Serial #

No. Nitrification Fields: 1 No. Lines 3 Linear Feet 200

Trench Width 36 Max. Trench Bottom Depth 36" Gravel Depth 36

☐ New System ☒ Repair ☐ Expansion System Type I II (III) IV V VI

System Description:

Repair System Description: 25% Reduction Gravity

Maintenance Agreement Required ☐ YES ☒ NO

☒ GRAVITY ☐ PRESSURE

☒ Residence No. Bedrooms 2

☐ Business No. Persons

☐ Other No. Employees

☐ Slab ☐ Crawl Space

☐ Basement w/plumbing ☒ Basement w/o plumbing

Water Supply


☒ Private

☐ Public

☐ Community

Comments / Conditions

INITIAL SITE SKETCH

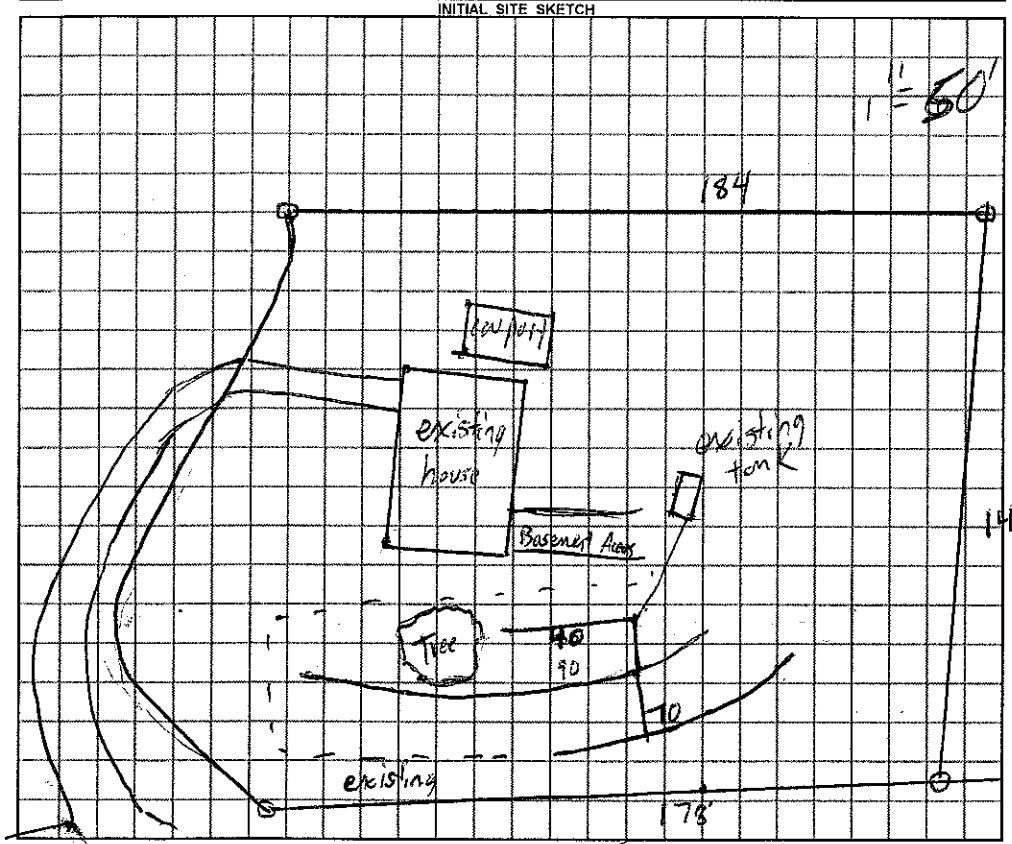

AS BUILT SKETCH

Installed new tee w/filter

Permit can be suspended or revoked if any false information is supplied toward securing the permit / any unauthorized changes are made to the site / any unauthorized changes are made in the installation of the system.

☐ ***IMPROVEMENT PERMIT*** *with plat valid without expiration.* ☒ ***IMPROVEMENT PERMIT*** *with ~~plat valid without expiration.~~ site plan valid 60 mo.* ☒ ***AUTHORIZATION TO CONSTRUCT*** valid for period equal to IMPROVEMENT PERMIT–not to exceed 60 mo.

Owner / Applicant Signature: Date

IMPROVEMENT PERMIT by: REHS Date 7-18-12

AUTHORIZATION TO CONSTRUCT by: REHS Date 7-18-12

YOU SHOULD CONTACT A LOCATOR SERVICE PRIOR TO ANY EXCAVATION

Installed by: Lentz Septic

OPERATION PERMIT by: REHS Date 7-20-12

Existing System Inspected by: REHS Date

White Copy – Environmental Health YELLOW COPY (Final) Owner / Applicant PINK COPY (Initial) Owner / Applicant