IREDELL COUNTY HEALTH DEPARTMENT

Statesville Phone TR 3-7271 Mooresville Phone NO 3-1271

PERMIT TO INSTALL SEPTIC TANK

Permit NO. 1 Permit Date 4-17 1966

Owner Jet Mathews Address R# 2 Statesville, NC

Installed By Hedrick-C.L. Address

Location of Property Hwy 90, L 1st dirt Rd to house


Brookline

Tank		Capacity		Length of Lines		Fixtures	
Block	( )	1000	(✓)	225'	(✓)	No. of Baths	( )
Precast	( )	1250	( )	250'	( )	Dishwasher	( )
		1500	( )	Other		Garbage Grdr.	( )
		Other				Other	

NOTIFY HEALTH DEPARTMENT AT LEAST EIGHT HOURS BEFORE TANK IS TO BE INSPECTED.

Final Inspection 4-7 1966 Approved (✓) Disapproved ( )

Remarks Cover drain tile with Tuff-Lite material will to be kept 50 feet away from well & T.K. Installed.

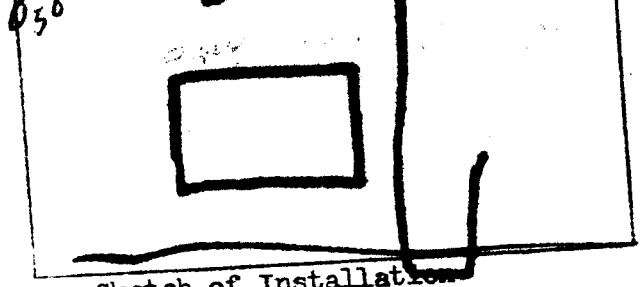

Sketch of Installation

Edward D. Hutchins RS

Sanitarian