Jerry Hutchens, 122 Butterfield Circle

IREDELL COUNTY HEALTH DEPARTMENT

STATESVILLE 704-878-5305 MOORESVILLE 704-664-5281

IMPROVEMENT PERMIT / AUTHORIZATION TO CONSTRUCT / OPERATION PERMIT / EXISTING SYSTEM INSPECTION

PERMIT# city of Statesville PIN# 4725 33 2460 DATE 5-28-98

OWNER OR CONTRACTOR Caster Edwards PHONE: Business _____ Home 803-8105

ADDRESS 120 Butterfield Rd

LOCATION 90 W To Butterfield In front of monticello school 3rd Hse Rt.

SUBDIVISION Delton Property BLOCK / SECTION _____ LOT 36 LOT AREA 100X180 SITE CLASS PS DESIGN FLOW 240 L.T.A.R. .3

Septic Tank: 1000 Gallons; STB 184 Date 11-5-01

Pump Tank: _____ Gallons; PT _____ Date _____

Pump Make: _____ Model _____ Serial No. _____

Nitrification Field: No. Fields 1 Square Feet 810 Linear Feet 270

No. Lines 4 Trench Width 36" Max Trench Bottom Depth 36" Gravel Depth 12"

☑ New System ☐ Repair System Type: ☐ I ☐ II, ☐ III, ☐ IV, ☐ V, ☐ VI

System Description: Conv. Gravity

Repair System Description: Pump to Chambers

Maintenance Agreement Required: ☐ Yes ☑ No

☑ House/Mod. Home ☐ Mobile Home ☐ Business ☐ Other

No. Bedrooms 2 No. Bathrooms 2 No. Employees _____

☐ Slab ☑ Crawl Space ☐ Basement w/plumbing ☐ Basement wo/plumbing


Water Supply: ☐ Individual ☑ Public ☐ Community

Comments/Conditions:

drop boxes

Comments/Conditions: LABEL EJECTOR & MARKER LINES HAD 44" FALL ACCEPTABLE BY STATE RULES SHOT ELEVATIONS & WOULD BACK UP TO DROP BOX OUTLET. ~~CONDITIONS~~ INITIAL

INITIAL SITE SKETCH

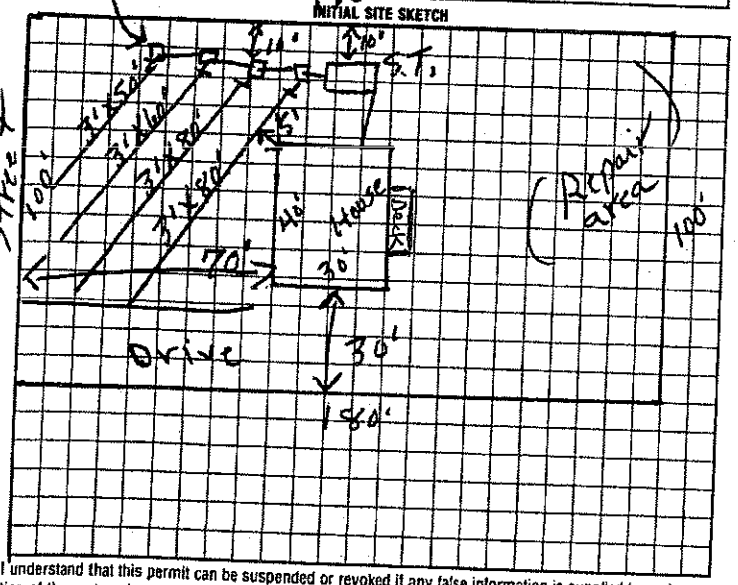

AS BUILT SKETCH LAYOUT WAS CLOSER THAN 15' FROM TOP OF DITCH (CUT) BUT FD EXACTLY AS DRAWN.

I understand that this permit can be suspended or revoked if any false information is supplied toward securing the permit/any unauthorized changes are made to the site/any unauthorized changes are made in the installation of the system. Improvement Permit with plat valid without expiration. Improvement Permit with site plan valid for sixty months. Authorization to Construct is valid for a period equal to that of Improvement Permit – not to exceed sixty months.

Signed: Caster Edwards date _____ Installed by: BOB'S BACKHOE

Improvement Permit by: L.C. Moore date 5-28-98 Operation Permit by: _____ date 04-15-07

Authorization to Construct by: L.C. Moore date 5-28-98 Existing System Inspection by: _____ date _____

HEALTH DEPT. COPY: WHITE INSPECTION COPY (FINAL): GREEN OWNER COPY (FINAL): YELLOW INSPECTION COPY (INITIAL): PINK OWNER COPY (INITIAL): GOLD

Location of the proposed Deck - 12'X20' addition does not appear to impact the existing on-site septic system.NOTE:** _____

_____ REHS

Date: April 15, 2013

ICHD-Environmental Health Division