IREDELL COUNTY HEALTH DEPARTMENT

Statesville Phone TR 3-7271 Mooresville Phone NO 3-1271

PERMIT TO INSTALL SEPTIC TANK

Permit NO. _____ Permit Date July 30 1959

Owner John Strickland Address Montezuma Dr. Ext

Installed By C Yoke Address R7


Location of Property Across from school - behind new Texaco Sta 1/2 on left. Taylorsville Rd.

Tank		Capacity		Length of Lines		Fixtures	
Block	( )	800	(✓)	150'	( )	No. of Baths	(1)
Precast	(✓)	900	( )	175'	( )	Dishwasher	( )
Lash		1000	( )	200'	( )	Garbage Grdr.	( )
		1100	( )	225'	(✓)	Auto-Washer	(✓)
		1200	( )	250'	( )	Other	
		Other		Other			

NOTIFY HEALTH DEPARTMENT AT LEAST EIGHT HOURS BEFORE TANK IS TO BE INSPECTED.

Final Inspection July 30 1959 Approved ( ) Disapproved ( )

Remarks Self Oper

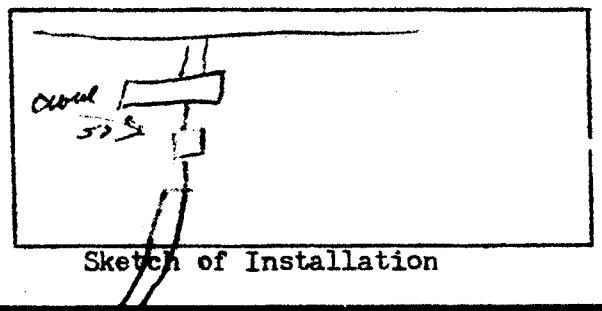

Sketch of Installation

R. G. L.

Sanitarian