IREDELL COUNTY HEALTH DEPARTMENT

Statesville Phone TR 3-7271 Mooresville Phone NO 3-1271

PERMIT TO INSTALL SEPTIC TANK

Permit NO._____ Permit Date 9-30 1963

Owner CAROLINA PETROLEUM CO Address_____

Installed By SMITH SEPTIC Address CATAWBA

Location of Property UP #90 WEST PASS MONTICELLO TEXICO


NEXT PLACE ON LEFT

Tank		Capacity		Length of Lines		Fixtures	
Block	( )	800	( )	150'	( )	No. of Baths	(1)
Precast	(✓)	900	( )	175'	( )	Dishwasher	( )
		1000	(✓)	200'	( )	Garbage Grdr.	( )
		1100	( )	225'	(✓)	Auto-Washer	( )
		1200	( )	250'	( )	Other_____	
		Other_____		Other_____			

NOTIFY HEALTH DEPARTMENT AT LEAST EIGHT HOURS BEFORE TANK IS TO BE INSPECTED.

Final Inspection 9-30 1963 Approved (✓) Disapproved ( )

Remarks_____

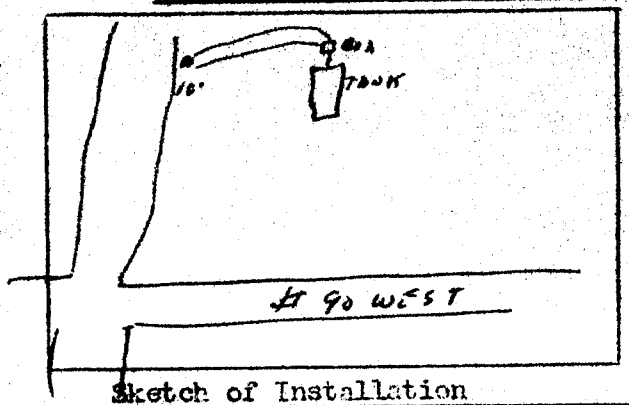

Sketch of Installation

STONE DIRTY BUT CERTIFIED TO BE WASHED!

Rafael A. Thomas, R.S.

Sanitarian