IREDELL COUNTY HEALTH DEPARTMENT

STATESVILLE 704-878-5305 MOORESVILLE 704-664-5281

IMPROVEMENT PERMIT / CERTIFICATE OF COMPLETION / OPERATION PERMIT / EXISTING SYSTEM INSPECTION

PROPERTY DESCRIPTION NO. City of Statesville DATE 1-14-94 TAX MAP NO. 9D-3B-3238 Watershed: ☐ Yes ☑ No

OWNER OR CONTRACTOR Coleman Absher (Big A Autoparts) PHONE: Business 873-7218 Home

ADDRESS 3321 Sedgefield Rd. Statesville, N.C. 28677

LOCATION I-40W TR Hwy 90 Business on L just past Butterfield Rd.

SUBDIVISION NA BLOCK / SECTION NA LOT NA LOT AREA ± 1.0 acre SITE CLASS Existing DESIGN FLOW NA L.T.A.R. Existing

Septic Tank: ____ Gallons: STB ____ Date ____
Pump Tank: ____ Gallons: PT ____ Date ____
Pump Make: Existing Model System Serial No ____
Nitrification Field: No Fields ____ Square Feet ____ Linear Feet ____
No Lines ____ Trench Width ____ Max French Bottom Depth ____ Gravel Depth ____

☐ New System ☐ Repair System Type: I. II. III. IV. V. VI
System Description: Existing System
Repair System Description:
Maintenance Agreement Required: ☐ Yes ☐ No

☐ House/Mod. Home No. Bedrooms ____
☐ Mobile Home No. Bathrooms ____
☑ Business No. Employees 4
☑ Other Addition to Building


☑ Slab ☐ Crawl Space ☐ Basement w/plumbing ☐ Basement wo/plumbing

Water Supply:
☑ Individual
☐ Community
☐ Public


Comments:

Comments: Keep Addition min. 5' from any part of the septic system. System shows no visible signs of malfunction at time of inspection.

INITIAL SITE SKETCH

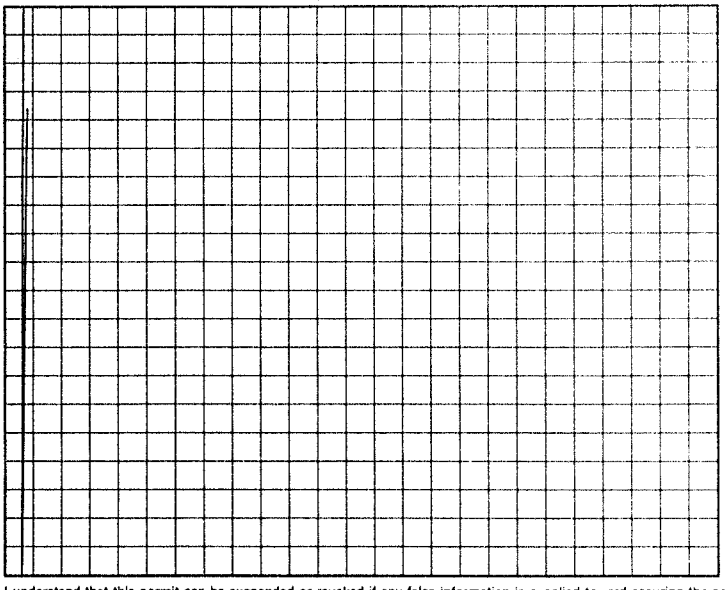

AS BUILT SKETCH

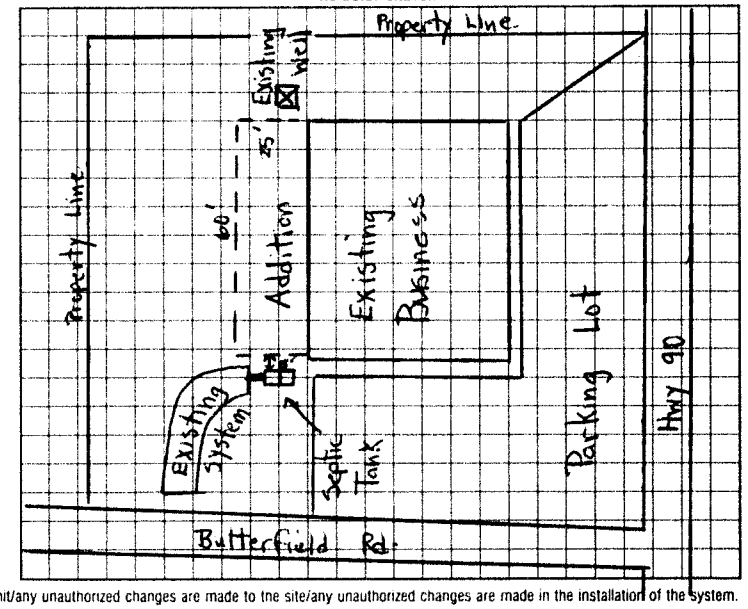

I understand that this permit can be suspended or revoked if any false information is supplied toward securing the permit/any unauthorized changes are made to the site/any unauthorized changes are made in the installation of the system. Improvement Permit is valid for 60 months from date of issuance.

Signed: ____ Installed by: ____

Improvement Permit by: ____ date ____ Certificate of Completion by: ____ date ____

Existing System Inspection by: Michael J. Dennis date 1-14-94 Operation Permit by: ____ date ____

HEALTH DEPT. COPY: WHITE INSPECTION COPY (FINAL): GREEN OWNER COPY (FINAL): YELLOW INSPECTION COPY (INITIAL): PINK OWNER COPY (INITIAL): GOLD