IREDELL COUNTY HEALTH DEPARTMENT

STATESVILLE 704-878-5305 MOORESVILLE 704-664-5281

IMPROVEMENT PERMIT / CERTIFICATE OF COMPLETION / OPERATION PERMIT / EXISTING SYSTEM INSPECTION

PROPERTY DESCRIPTION NO. Repair DATE 4-30-97 TAX MAP NO. Repair

OWNER OR CONTRACTOR Phil Ingram PHONE: Business _____ Home 872-3546 Watershed: ☐ Yes ☐ No

ADDRESS 161 Travis Loop St Statesville NC

LOCATION 90W TR Mahaffey Rd TL Travis Loop

SUBDIVISION _____ BLOCK / SECTION _____ LOT _____ LOT AREA _____ SITE CLASS. _____ DESIGN FLOW _____ L.T.A.R. _____

Septic Tank: Existing Tank Gallons: STB _____ Date _____

Pump Tank: _____ Gallons; PT _____ Date _____

Pump Make: _____ Model _____ Serial No. _____

Nitrification Field: No Fields 1 Square Feet _____ Linear Feet _____

No Lines Bed 2 Trench Width 6ft Max Trench Bottom Depth 36in

☐ New System ☒ Repair System Type: I, ⓘ III, IV, V, VI

System Description: _____

Repair System Description: Gravity Conventional

Maintenance Agreement Required: ☐ Yes ☐ No

☒ House/Mod. Home No. Bedrooms 2

☐ Mobile Home No. Bathrooms ___

☐ Business No. Employees ___

☐ Other _____


Gravel Depth 18in ☐ Slab ☐ Crawl Space ☐ Basement w/plumbing ☐ Basement wo/plumbing

Water Supply: ☐ Individual ☐ Community ☒ Public


Comments: Bed 6ft wide with 2 pipes in Gravel Check tank + sanitary T replace if needed Watch for water line - keep 10ft from line

Comments:

INITIAL SITE SKETCH

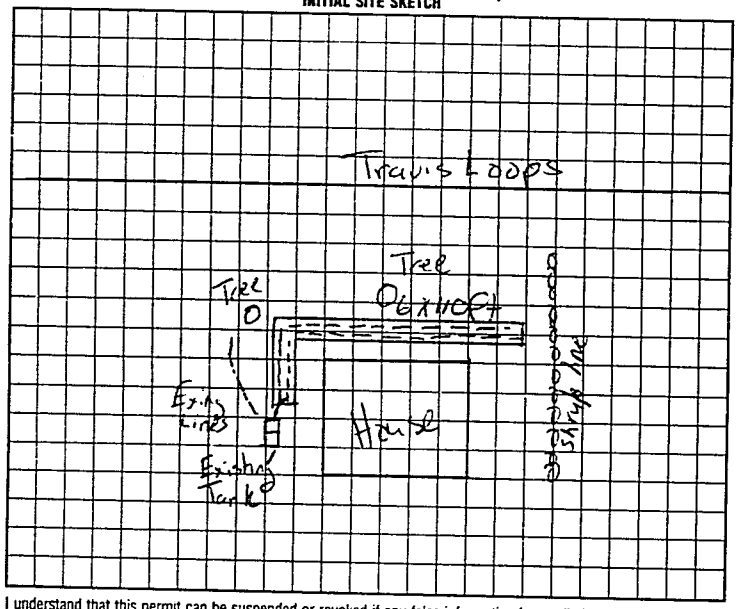

AS BUILT SKETCH

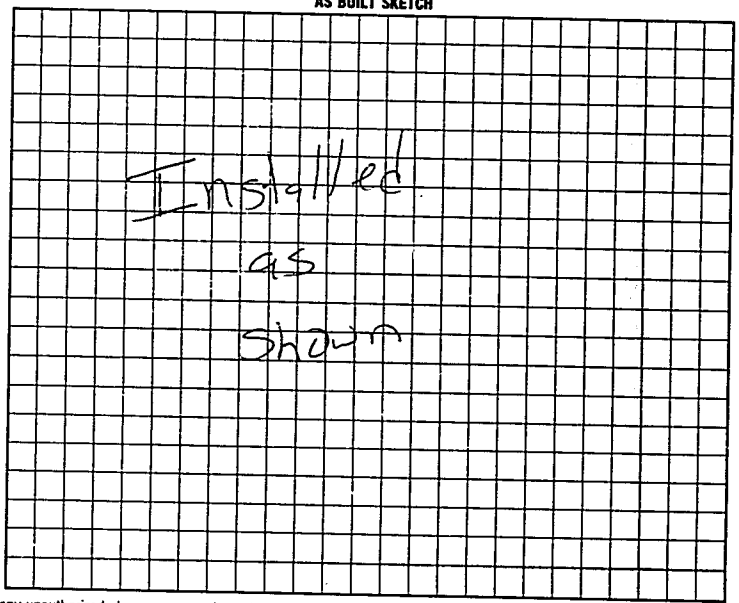

I understand that this permit can be suspended or revoked if any false information is supplied toward securing the permit/any unauthorized changes are made to the site/any unauthorized changes are made in the installation of the system. Improvement Permit is valid for 60 months from date of issuance.

Signed: Phil Ingram

Improvement Permit by: Mark C Orf RS date 4-30-97

Authorization to Const. Existing System Inspection by: Mark C Orf RS date 4-30-97

Installed by: Esker Elder

Certificate of Completion by: _____ date _____

Operation Permit by: Mark C Orf RS date 5-29-97

HEALTH DEPT. COPY: WHITE INSPECTION COPY (FINAL): GREEN OWNER COPY (FINAL): YELLOW INSPECTION COPY (INITIAL): PINK OWNER COPY (INITIAL): GOLD