IREDELL COUNTY HEALTH DEPARTMENT

Statesville Phone TR 3-7271 Mooresville Phone NO 3-1271

PERMIT TO INSTALL SEPTIC TANK

Permit No. 133 M + T Sales Permit Date 6-16 1972

Owner Frank Hofath Address Statesville NC

Installed By Harlee Lackey Address Stony Point NC


Location of Property Out Hwy 90 to Kens Gro T.R. on #1546 Trailer Park on Rt 5 Tu trailer on Rt. 1st St Grayson Park

Tank		Capacity		Length of Lines		Fixtures	
Block	( )	1000	(✓)	225'	(✓)	No. of Baths	(1)
Precast	(✓)	1250	( )	250'	( )	Dishwasher	( )
		1500	( )	Other		Garbage Grdr.	( )
		Other				Other	

NOTIFY HEALTH DEPARTMENT AT LEAST EIGHT HOURS BEFORE TANK IS TO BE INSPECTED.

Final Inspection 5-16 1972 Approved (✓) Disapproved ( )

Remarks Community Water

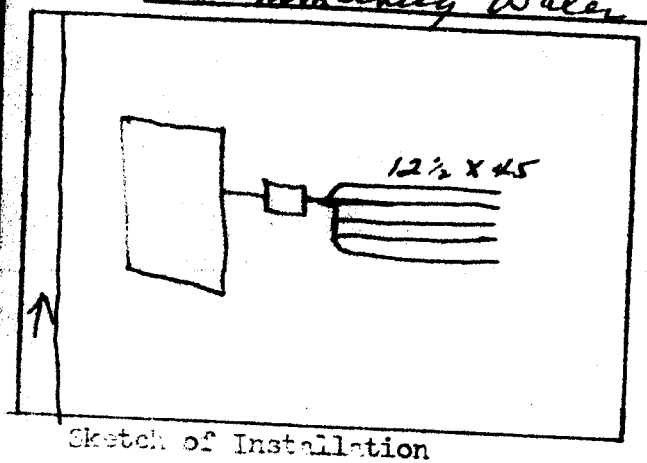

Sketch of Installation

Lot # 5

E. A. Stevenson

Sanitarian