IREDELL COUNTY HEALTH DEPARTMENT

Statesville Phone TR 3-7271 Mooresville Phone NO 3-1271

PERMIT TO INSTALL SEPTIC TANK

Permit No. 133 M+T Sales Permit Date 6-16 1972

Owner Frank Dofarth Address Statesville NC

Installed By Harlen Lackey Address Stony Point NC


Location of Property Out Hwy 90 to Kens Gro T.R. on 1546 Trailer Park on R. 6 Trailer on R. 1st St Grayson Park.

Tank		Capacity		Length of Lines		Fixtures	
Block	( )	1000	(✓)	225'	(✓)	No. of Baths	( )
Precast	(✓)	1250	( )	250'	( )	Dishwasher	( )
		1500	( )	Other		Garbage Grdr.	( )
		Other				Other	

NOTIFY HEALTH DEPARTMENT AT LEAST EIGHT HOURS BEFORE TANK IS TO BE INSPECTED.

Final Inspection 5-16 1972 Approved (✓) Disapproved ( )

Remarks Community Water.

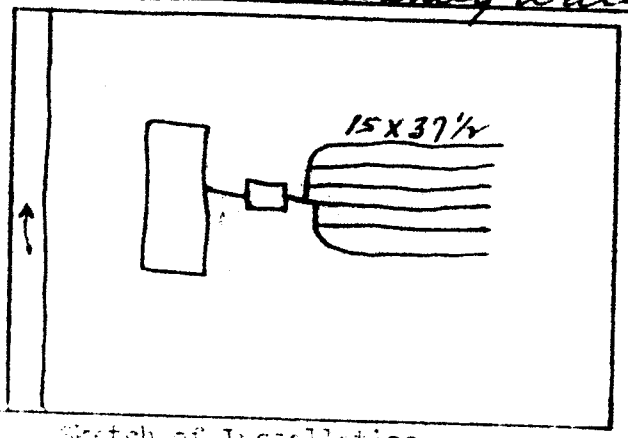

Sketch of Installation

Lot #6

E. A. Stevenson

Sanitarian