IREDELL COUNTY HEALTH DEPARTMENT

Statesville Phone TR 3-7271 Mooresville Phone NO 3-1271

PERMIT TO INSTALL SEPTIC TANK

Permit No. 133 MH 7 Sales Permit Date 6-16 1972

Owner Frank Hefner Address Statesville N.C.

Installed By Harlee Lackey Address Stony Point N.C.


Location of Property out Hwy #90 to Kens Gro T.R. on #1546. Trailer Park on R. T.R. 7th trailer on R. 1st St. Grayson Park

Tank		Capacity		Length of Lines		Fixtures	
Block	( )	1000	(✓)	225'	(✓)	No. of Baths	(1)
Precast	(✓)	1250	( )	250'	( )	Dishwasher	( )
		1500	( )	Other		Garbage Grdr.	( )
		Other				Other	

NOTIFY HEALTH DEPARTMENT AT LEAST EIGHT HOURS BEFORE TANK IS TO BE INSPECTED.

Final Inspection 6-16 1972 Approved (✓) Disapproved ( )

Remarks Community Water

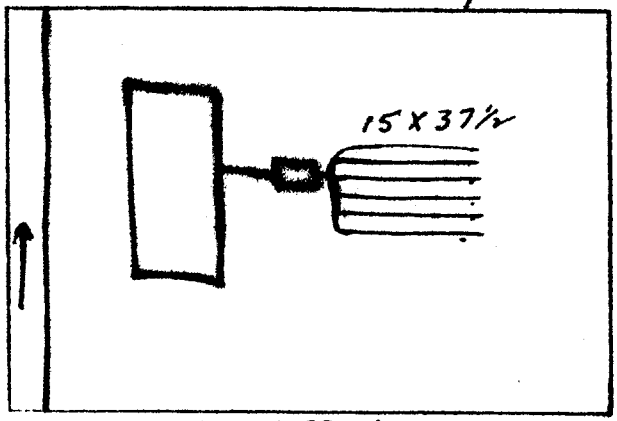

Lot #7

Sketch of Installation

E. A. Stevenson

Sanitarian