52830

IREDELL COUNTY HEALTH DEPARTMENT

STATESVILLE 704-878-5305 MOORESVILLE 704-664-5281

IMPROVEMENT PERMIT / CERTIFICATE OF COMPLETION / OPERATION PERMIT / EXISTING SYSTEM INSPECTION

PROPERTY DESCRIPTION NO. 19403 DATE 9/16/94 TAX MAP NO. 9D-11-A-25 Watershed: ☐ Yes ☑ No

OWNER OR CONTRACTOR NELLIE FOX PHONE: Business (FAMILY CIRCLE) Home 872-7498

ADDRESS RT. 17 STILL

LOCATION NC 90 W, TR GRAYSON PARK ROAD, TR 2ND MHP DRIVE, 5TH MH LOT ON RIGHT

SUBDIVISION GRAYSON MHP BLOCK / SECTION ____ LOT 25 LOT AREA LIMITED SITE CLASS PS' DESIGN FLOW ____ L.T.A.R. EXISTING

Septic Tank: EXISTING Gallons; STB ____ Date ____

Pump Tank: ____ Gallons; PT ____ Date ____

Pump Make: ____ Model ____ Serial No. ____

Nitrification Field: No Fields ____ Square Feet ____ Linear Feet EXISTING

No Lines ____ Trench Width ____ Max Trench Bottom Depth ____ Gravel Depth ____

☐ New System ☐ Repair System Type: I, II, III, IV, V, VI

System Description: CONVENTIONAL GRAVITY

Repair System Description: ____

Maintenance Agreement Required: ☐ Yes ☑ No

☐ House/Mod. Home ☑ Mobile Home ☐ Business ☐ Other

No. Bedrooms 2 No. Bathrooms 2 No. Employees ____


☐ Slab ☑ Crawl Space ☐ Basement w/plumbing ☐ Basement wo/plumbing

Water Supply: ☐ Individual ☐ Community ☑ Public


Comments:

Comments: KEEP MH MINIMUM 5' FROM SYSTEM

INITIAL SITE SKETCH

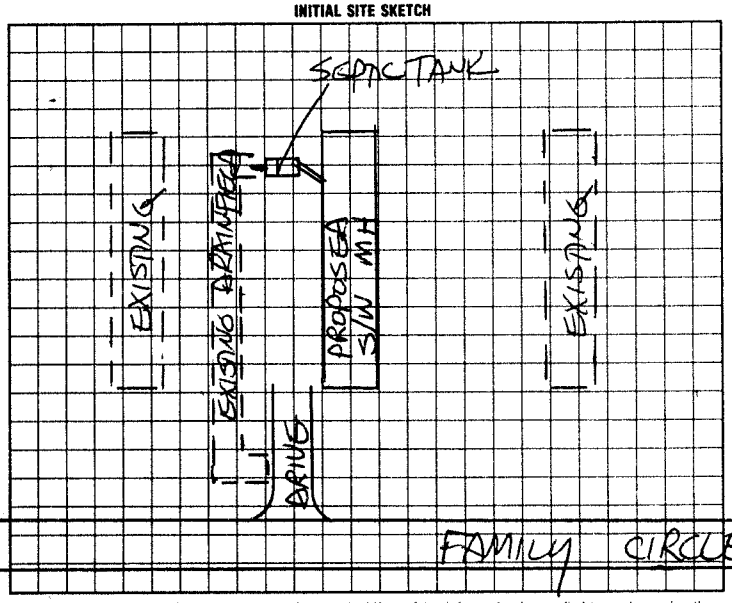

AS BUILT SKETCH

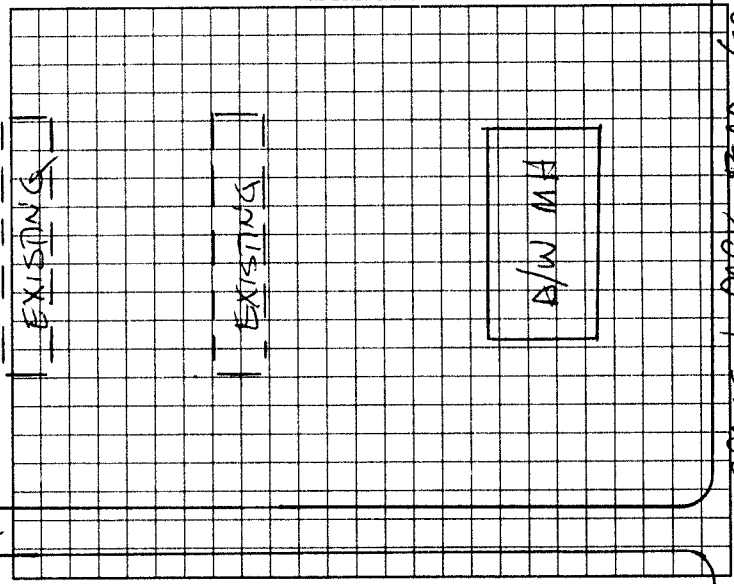

I understand that this permit can be suspended or revoked if any false information is supplied toward securing the permit/any unauthorized changes are made to the site/any unauthorized changes are made in the installation of the system. Improvement Permit is valid for 60 months from date of issuance.

Signed: ____

Improvement Permit by: ____ date ____

Existing System Inspection by: STEVE HEDRICK date 9/16/94

Installed by: ____

Certificate of Completion by: ____ date ____

Operation Permit by: ____ date ____

HEALTH DEPT. COPY: WHITE INSPECTION COPY (FINAL): GREEN OWNER COPY (FINAL): YELLOW INSPECTION COPY (INITIAL): PINK OWNER COPY (INITIAL): GOLD